


If well telescopes please sketch and show depths.

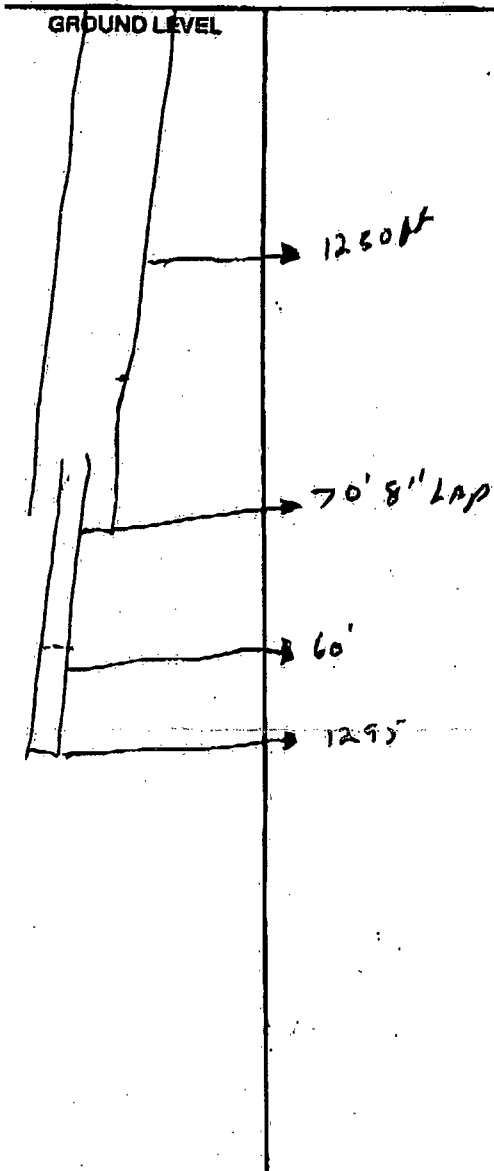

If more than one screen, show location of each on sketch.


SECTION \_\_\_\_\_

Please indicate well location X.

Pump Capacity (GPM)	No. of Stages	Setting Depth	
500	7	240	FT.
PUMP TEST			
Well yielded <u>550</u> GPM with			
a drawdown of <u>20</u> ft.			
after <u>4</u> hours of pumping			

LOG DATA

TYPE OF LOG RUN (Circle One): No Log Run.  
 Electric  Gamma Ray  Density  Sonic  Neutron  
 Other (Describe) \_\_\_\_\_

Name of Organization Running Log  
State

GEOLOGIC DATA (Office Use Only)

Surface Elev.	Geologic Unit	Unit Thickness	Depth to Top
Subs. SWL	Date	Analysis	Aquifer Test

Driller's Remarks

\_\_\_\_\_

\_\_\_\_\_

\_\_\_\_\_

\_\_\_\_\_

11-11-68