

Earl R.  
 05-3  
 3-23-66

**WATER WELL DRILLERS LOG**

Date: 3/23, 1966, Driller: Poppart County R. R.  
 70-5 (Name)

**CODED**

(1) Owner of Land: A. Weiss  
 (Name)  
Poplarville Rt.  
 (Address)

(2) Location: 1/4, 1/4, Sec. 19 T 4 R 14,  
15 miles S, of Poplarville  
 (distance) (direction) (Nearest Town)

(3) Topography:  (Hilly)  (Flat)  (Level)

(4) Purpose of Well: Home use  
 (Domestic Irrigation, Municipal, Industrial, Other)

Description & Color of Materials Sand, Clay, Red Clay, Shell, etc.	Thick-ness Feet	Depth Feet
<u>Red Clay</u>	<u>0</u>	<u>30</u>
<u>" Sand</u>	<u>30</u>	<u>100</u>

Information upon completion of well:

(1) Diameter 4 inches.

(2) Total Depth 100 feet.

(3) Water Level 80 feet below top of ground.

(4) Cased to \_\_\_\_\_, Size \_\_\_\_\_.


(5) Screen: Size 0/0, Length 5'.

(6) Were any formations sealed against pollution?  
 \_\_\_\_\_ yes, \_\_\_\_\_ no.

**CODED**

If YES depth of formation \_\_\_\_\_  
 Why \_\_\_\_\_

Drillers Remarks: \_\_\_\_\_

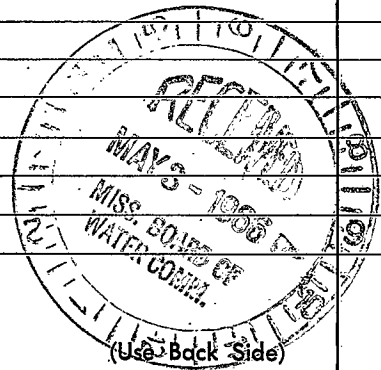

Well No.

