

**PEARL RIVER**  
**S4**  
**2-2-72**

MISSISSIPPI  
 BOARD OF WATER COMMISSIONERS  
 416 North State Street  
 Jackson, Mississippi 39201

MAR 8 1972

**CODED**

**WATER WELL DRILLERS LOG**

2-22 1972 Bud Kenton, Sr Pearl River  
 date well completed firm name county well located

LANDOWNER: William Strahan  
 Route 2  
 Poplarville, Miss.  
 (mailing address)

description of formations encountered	from	to
Red Shale	0	16
Red Sand	16	59
Blue Shale	59	240
Blue Sand	240	276

WELL LOCATION:  
 sec. 31 T. 4-N R. 14-E  
 5  
 12 miles E of Poplarville  
 (distance) (direction) (nearest town)

WELL PURPOSE: Home  
 (home, irrigation, municipal, industrial)

- WELL COMPLETION DATA:
- (1) diameter (inches) 4 in
  - (2) total depth (feet) 276
  - (3) static water level (feet) 149 ft below top of ground.
  - (4) casing PVC 266 (material) (depth)  
 (size) If telescope see back.
  - (5) screen 10 ft 266 (length) (depth to top)  
 4x10 PVC no 12 (size) (material)
  - (6) pump 1 750 (HP) (yield gpm)  
 electric (type power)
  - (7) electric log NO (yes or no)

**CODED**


(organization running log)

(8) how well bottom plugged  
 Sand Shank

DRILLERS REMARKS:

If well telescopes please sketch and show depths.

GROUND LEVEL

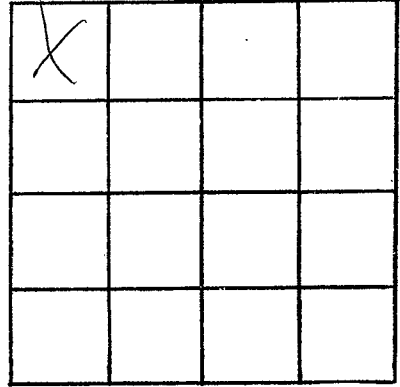

SECTION \_\_\_\_\_

Please indicate well location X.

ADDITIONAL INFORMATION

If more than one screen,  
show locations of each on sketch.