

PEARL RIVER
56
12-2-70

MISSISSIPPI
 BOARD OF WATER COMMISSIONERS
 416 North State Street
 Jackson, Mississippi 39201

WATER WELL DRILLERS LOG

Dec. 2 1970 Sand's Water Wells Pearl River county well located
 date well completed firm name

LANDOWNER: Fred Holmes
Rt. 2
Yalmonville Miss.
 (mailing address)

description of formations encountered	from	to
<u>Class</u>		<u>20</u>
<u>Coarse Sand</u>	<u>20</u>	<u>28</u>

WELL LOCATION:
 sec. 9 T. 4 N R. 14 E
14 miles SE of Yalmonville
 (distance) (direction) (nearest town)

WELL PURPOSE: Home
 (home, irrigation, municipal, industrial)

WELL COMPLETION DATA:
 (1) diameter (inches) 2"
 (2) total depth (feet) 28'
 (3) static water level (feet) 17' below ~~above~~ top of ground.
 (4) casing gal 23'
 (material) (depth)
2" if telescope see back.
 (size)
 (5) screen 5' 23'
 (length) (depth to top)
2" Stainless Steel
 (size) (material)
 (6) pump 1/2 5
 (HP) (yield gpm)
1/10
 (type power)
 (7) electric log _____
 (yes or no)
 (organization running log)
 (8) how well bottom plugged Sand Shale
Not enough water


JAN 6 - 1971

DRILLERS REMARKS:

MISS. BD. OF
 WATER COMM.

If well telescopes please sketch and show depths.

GROUND LEVEL

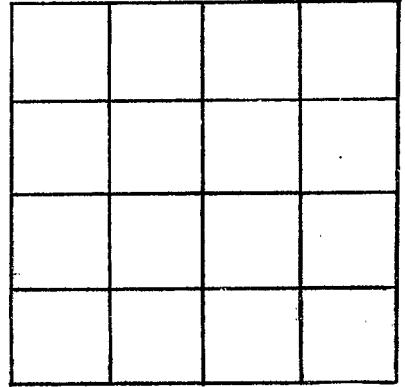

SECTION _____

Please indicate well location X.

ADDITIONAL INFORMATION

If more than one screen,
show locations of each on sketch.