

PEARL RIVER
S 8
7-10-72

MISSISSIPPI
BOARD OF WATER COMMISSIONERS
416 North State Street
Jackson, Mississippi 39201

CODED


WATER WELL DRILLERS LOG

July 10 1972 Walker Well Service Pearl River
date well completed firm name county well located

LANDOWNER: <u>Fred Wedner</u> <u>RT 2</u>	description of formations encountered	from	to
Perkinston, Miss (mailing address)	TOP soil	0	2
WELL LOCATION: sec. 1 T 4 N R 14 E <u>1/2</u> miles S of <u>Silver Run</u> (distance) (direction) (nearest town)	2 1/2 y sand	2	12
WELL PURPOSE: <u>home</u> (home, irrigation, municipal, industrial)	2 1/2 y (Blue) sand	12	36
WELL COMPLETION DATA: (1) diameter (inches) <u>2"</u>		35	120
(2) total depth (feet) <u>120'</u>		120	
(3) static water level (feet) <u>14'</u> below top of ground.			
(4) casing <u>P.</u> , <u>115'</u> (material) (depth)			
<u>2</u> if telescope see back. (size)			
(5) screen <u>5'</u> , <u>115'</u> (length) (depth to top)			
<u>2</u> , <u>P.</u> (size) (material)			
(6) pump <u>1/2</u> , <u>14</u> (HP) (yield gpm)			
<u>Elect.</u> (type power)			
(7) electric log <u>no</u> (yes or no)			
(8) how well bottom plugged <u>Cap</u> (organization running log)			
DRILLERS REMARKS:			

If well telescopes please sketch and show depths.

GROUND LEVEL

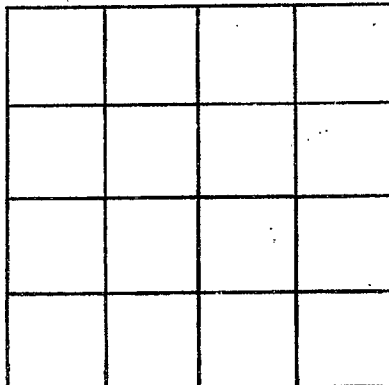

SECTION _____

Please indicate well location X.

ADDITIONAL INFORMATION

If more than one screen,
show locations of each on sketch.