

PEARL RIVER
 59
 7-18-72

MISSISSIPPI
 BOARD OF WATER COMMISSIONERS
 416 North State Street
 Jackson, Mississippi 39201

CODE

WATER WELL DRILLERS LOG

July 18 1972 date well completed
 W & W Well Service firm name
 Pearl River county well located


LANDOWNER: <u>Howard Lubiner</u>	description of formations encountered	from	to
Rt 2 Poplarville, Miss (mailing address)	top soil clay (Red) clay (Blue)	0 1 37 45	1 37 45
WELL LOCATION:			
sec. <u>28</u> T <u>4</u> S R <u>14</u> W <u>3</u> miles <u>West</u> of <u>North</u> (distance) (direction) (nearest town)			
WELL PURPOSE: <u>None</u> (home, irrigation, municipal, industrial)			
WELL COMPLETION DATA:			
(1) diameter (inches) <u>2"</u>			
(2) total depth (feet) <u>45'</u>			
(3) static water level (feet) <u>29'</u> below top of ground.			
(4) casing <u>P.</u> , <u>40</u> , (material) (depth)			
<u> </u> if telescope see back. (size)			
(5) screen <u>5</u> , <u>40</u> (length) (depth to top)			
(6) pump <u>1</u> , <u>P</u> (size) (material)			
(6) pump <u>1</u> , <u>15</u> (HP) (yield gpm)			
<u>Elect.</u> (type power)			
(7) electric log <u>NO</u> (yes or no)			
<u> </u> (organization running log)			
(8) how well bottom plugged <u>Cap</u>			
DRILLERS REMARKS:			

JUL 18 1972

MISS. BD. OF
 WATER COM.

If well telescopes please sketch and show depths.

GROUND LEVEL

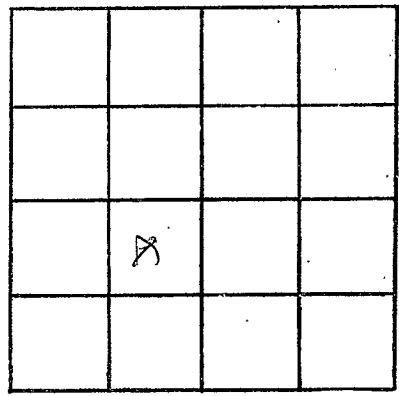

SECTION 28

Please indicate well location X.

ADDITIONAL INFORMATION

Lined area for additional information.

If more than one screen, show locations of each on sketch.