

PEARL RIVER
S 10
1-10-73

MISSISSIPPI
BOARD OF WATER COMMISSIONERS
416 North State Street
Jackson, Mississippi 39201

CODED

WATER WELL DRILLERS LOG

Jan 10 1973 *S & S* Pearl River
date well completed firm name county well located

LANDOWNER: *Billy R. Lebow*
Poplarville, Miss.
(mailing address)

description of formations encountered	from	to
<i>top soil</i>	<i>0</i>	<i>2</i>
<i>Clay</i>	<i>2</i>	<i>40</i>
<i>sand</i>	<i>40</i>	<i>50</i>
<i>Clay</i>	<i>50</i>	<i>210</i>
<i>sand</i>	<i>210</i>	<i>240</i>

WELL LOCATION:
sec. *29* T. *4* N. R. *14* E.
miles *Steep* of *Fallow*
(distance) (direction) (nearest town)

WELL PURPOSE: *Home*
(home, irrigation, municipal, industrial)

- WELL COMPLETION DATA:
- (1) diameter (inches) *2*
 - (2) total depth (feet) *240*
 - (3) static water level (feet) *80* below above top of ground.
 - (4) casing *PVC* *130*
(material) (depth)
2" if telescope see back.
(size)
 - (5) screen *10'* *230*
(length) (depth to top)
2" *PVC*
(size) (material)
 - (6) pump *1* *6*
(HP) (yield gpm)
E1
(type power)
 - (7) electric log *No*
(yes or no)

(organization running log)
 - (8) how well bottom plugged *B.W.*


CODED

DRILLERS REMARKS: _____

JAN 29 1973

If well telescopes please sketch and show depths.

GROUND LEVEL

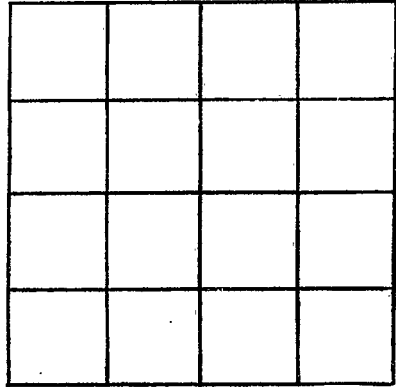

SECTION _____

Please indicate well location X.

ADDITIONAL INFORMATION

Lined area for additional information.

If more than one screen, show locations of each on sketch.