

PEARL RIVER
511
11-8-72

MISSISSIPPI
BOARD OF WATER COMMISSIONERS
416 North State Street
Jackson, Mississippi 39201

WATER WELL DRILLERS LOG


CODED

11-8-72 Earl Perston water Pearl River
date well completed firm name county well located

LANDOWNER:	description of formations encountered	from	to
Mr. D.W. Smith	Red clay	0	10
Poplarville miss. (mailing address)	white co. sd.	10	34
WELL LOCATION:	Red clay	34	42
sec 30 T 4 N R 14 E 6 miles South of Savannah (distance) (direction) (nearest town)	White clay	42	56
WELL PURPOSE: Home (home, irrigation, municipal, industrial)	Blue clay	56	208
WELL COMPLETION DATA:	med. Blue sd.	208	256
(1) diameter (inches) 4.5			
(2) total depth (feet) 268			
(3) static water level (feet) 104 below top of ground.			
(4) casing Galv. 263. (material) (depth)			
2" if telescope see back. (size)			
(5) screen 5' 263 (length) (depth to top)			
2" 5.5. (size) (material)			
(6) pump 1 320 H. (HP) (yield gpm)			
Elec. (type power)			
(7) electric log NO (yes or no)			
(organization running log)			
(8) how well bottom plugged 3/4			
DRILLERS REMARKS:			

If well telescopes please
sketch and show depths.

GROUND LEVEL

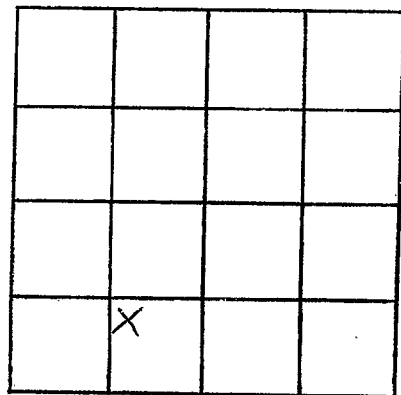

SECTION 20

Please indicate well location X.

ADDITIONAL INFORMATION

If more than one screen,
show locations of each on sketch.