

P.R.
 513
 6-6-73

MISSISSIPPI
 BOARD OF WATER COMMISSIONERS
 416 North State Street
 Jackson, Mississippi 39201

CODED

WATER WELL DRILLERS LOG

6-6 1973 Earl Penton Water Well Serv. Pearl River
 date well completed firm name county well located

LANDOWNER:
Mrs Annie Horne
Poplarville Miss.
 (mailing address)

description of formations encountered	from	to
<u>white clay</u>	<u>0</u>	<u>8</u>
<u>white sd. & gravel</u>	<u>8</u>	<u>21</u>
<u>blue clay</u>	<u>21</u>	<u>206</u>
<u>fine blue sd.</u>	<u>206</u>	<u>240</u>
<u>med. blue sand</u>	<u>240</u>	<u>258</u>

WELL LOCATION:
 sec 17 T 4 N R 14 E
12 miles west of Millard
 (distance) (direction) (nearest town)

WELL PURPOSE: Home
 (home, irrigation, municipal, industrial)

- WELL COMPLETION DATA:
- (1) diameter (inches) 4.5
 - (2) total depth (feet) 258
 - (3) static water level (feet) 24 below/above top of ground.
 - (4) casing Cas 253
 (material) (depth)
3" if telescope see back.
 (size)
 - (5) screen 5 253
 (length) (depth to top)
2 5.5
 (size) (material)
 - (6) pump 1 450 lbs.
 (HP) (yield gpm)
Elect
 (type power)
 - (7) electric log No
 (yes or no)
- (organization running log)
- (8) how well bottom plugged Shoe

CODED


DRILLERS REMARKS:

8 19/8

MISSISSIPPI
 BOARD OF WATER COMMISSIONERS

If well telescopes please sketch and show depths.

GROUND LEVEL

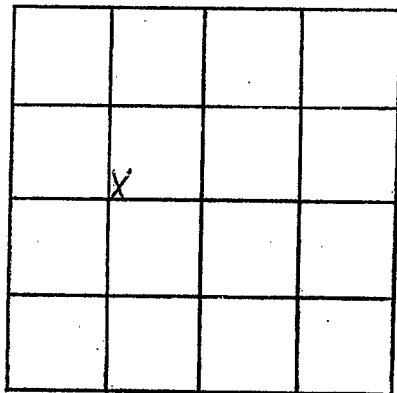

SECTION 17

Please indicate well location X.

ADDITIONAL INFORMATION

If more than one screen,
show locations of each on sketch.