

PEARL RIVER
 528
 8-28-70

MISSISSIPPI
 BOARD OF WATER COMMISSIONERS
 416 North State Street
 Jackson, Mississippi 39201

CODED

WATER WELL DRILLERS LOG

Aug 28 19 515 Well Works Beal River County
 date well completed firm name county well located

LANDOWNER:	description of formations encountered	from	to
<u>Conrail Hamel</u>	<u>top soil</u>	<u>0</u>	<u>24</u>
<u>Bob Larnell Miss</u> (mailing address)	<u>Clay</u>	<u>2</u>	<u>18</u>
	<u>Sand</u>	<u>13</u>	<u>50</u>
WELL LOCATION:	<u>Clay</u>	<u>50</u>	<u>265</u>
sec. <u>22</u> T <u>11</u> N R. <u>14</u> E	<u>Sand</u>	<u>265</u>	<u>295</u>
<u>7</u> miles <u>N</u> of <u>Booth</u>			
WELL PURPOSE: (home, irrigation, municipal, industrial)			
WELL COMPLETION DATA:			
(1) diameter (inches) <u>2in.</u>			
(2) total depth (feet) <u>295</u>			
(3) static water level (feet) <u>100</u> ^{below} / _{above} top of ground.			
(4) casing <u>Metall</u> <u>285</u> (material) (depth)			
<u>2in.</u> if telescope see back. (size)			
(5) screen <u>10 ft</u> <u>285</u> (length) (depth to top)			
<u>2in.</u> <u>S.S.</u> (size) (material)			
(6) pump <u>1</u> <u>7</u> (HP) (yield gpm)			
<u>E</u> (type power)			
(7) electric log <u>No</u> (yes or no)			
(organization running log)			
(8) how well bottom plugged <u>Blw</u>			
DRILLERS REMARKS:			
<u>None</u>			


CODED

OCT 2 1970

MISS. STATE WATER BOARD

If well telescopes please sketch and show depths.

GROUND LEVEL

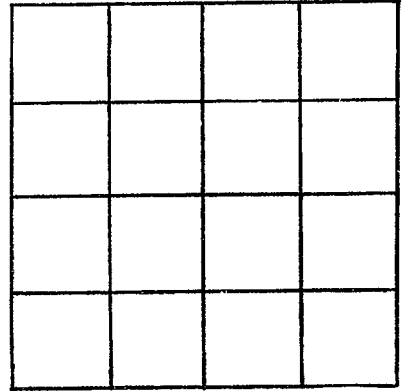

SECTION _____

Please indicate well location X.

ADDITIONAL INFORMATION

If more than one screen,
show locations of each on sketch.