

6

Pearl River  
S29  
2-68

MISSISSIPPI  
BOARD OF WATER COMMISSIONERS  
416 North State Street  
Jackson, Mississippi 39201

**CODED**

WATER WELL DRILLERS LOG

2-18 19 Leo Labal Pearl River  
date well completed firm name county well located

LANDOWNER: Butch Laird

description of formations encountered	from	to
Surface	0	1
Clay	18	89
Sand	18	52
Blue Clay	19	52
Sand	52	64

Poplarville Miss  
(mailing address)

WELL LOCATION:

sec. 13 T N R E  
4 S 14 W  
1.20 miles SE of Poplarville  
(distance) (direction) (nearest town)

WELL PURPOSE: Home  
(home, irrigation, municipal, industrial)

WELL COMPLETION DATA:


- (1) diameter (inches) 2"
- (2) total depth (feet) 104
- (3) static water level (feet) 40 below top of ground.
- (4) casing Plastic 60,  
(material) (depth)  
2"  
(size) if telescope see back.
- (5) screen 5', 59  
(length) (depth to top)  
2", Plastic  
(size) (material)
- (6) pump 1 12  
(HP) (yield gpm)  
Elec  
(type power)
- (7) electric log NO  
(yes or no)

**CODED**

(organization running log)


(8) how well bottom plugged Butake

DRILLERS REMARKS:

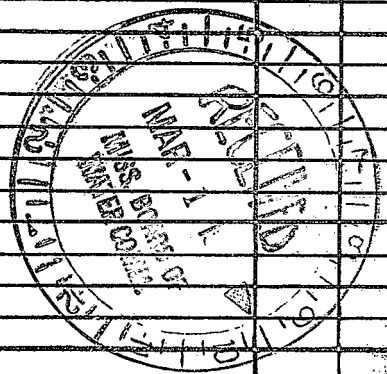

If well telescopes please sketch and show depths.

GROUND LEVEL

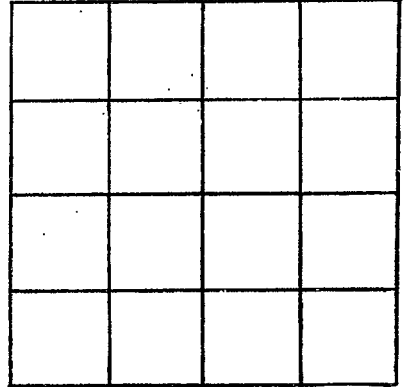

SECTION 13

Please indicate well location X.

ADDITIONAL INFORMATION

If more than one screen, show locations of each on sketch.