

Pearl River
 S31
 7-16-82

MISSISSIPPI DEPARTMENT OF NATURAL RESOURCES
 Bureau of Land and Water Resources
 Southport Mall
 P.O. Box 10631
 Jackson, Mississippi 39209
 WATER WELL DRILLERS LOG


7-16-82 date well completed
 POUNCEY WATER WELL DRILLING firm name
 Pearl River county well located

| LANDOWNER: <u>Mr. Jeff Smith</u> | description of formations encountered | from | to |
|---|---------------------------------------|------------|------------|
| <u>Steep Hollow -</u> | | | |
| (mailing address) | <u>top</u> | <u>0</u> | <u>6</u> |
| WELL LOCATION: sec. <u>23</u> T <u>4</u> N R <u>14</u> E <u>7/4</u> miles <u>S</u> of <u>Steep Hollow</u> <u>W</u> (distance) (direction) (nearest town) | <u>Junk sd.</u> | <u>6</u> | <u>23</u> |
| WELL PURPOSE: <u>House</u> (home, irrigation, municipal, industrial) | <u>Clay Blue -</u> | <u>23</u> | <u>218</u> |
| WELL COMPLETION DATA: (1) diameter (inches) <u>2</u> (2) total depth (feet) <u>250</u> (3) static water level (feet) <u>110</u> below top of ground (4) casing <u>Pvc</u> <u>240</u> (material) (depth) <u>2</u> if telescope see back. (size) (5) screen <u>10</u> <u>240</u> (length) (depth to top) <u>2</u> <u>Pvc</u> (size) (material) (6) pump <u>1 1/2</u> <u>6</u> (HP) (yield gpm) <u>Ac 200</u> (type power) (7) electric log <u> </u> (yes or no) (organization running log) <u>Gold.</u> (8) how well bottom plugged <u> </u> | <u>fine mix -</u> | <u>218</u> | <u>250</u> |
| DRILLERS REMARKS: | | | |

DEPT. OF NATURAL RESOURCES
 BUREAU OF LAND & WATER RESOURCES
 AUG - 8 1982
RECEIVED

If well telescopes please sketch and show depths.

GROUND LEVEL

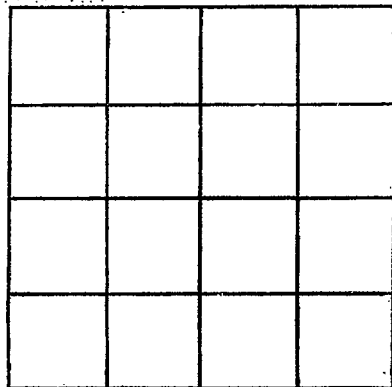

SECTION _____

Please indicate well location X.

ADDITIONAL INFORMATION

If more than one screen, show locations of each on sketch.