

Pearl River
Stone

MISSISSIPPI DEPARTMENT OF ENVIRONMENTAL QUALITY
Office of Land and Water Resources

POINCEY WATER WELLS

Adron A. Pouncey
10200 Possom Fork
Picayune, MS 39466

P. O. Box 10631
Jackson, MS 39289-0631
WATER WELL DRILLERS LOG

COUNTY/WELL LOCATED	Stone
WELL NUMBER	5-36
CODED	
PERMIT NUMBER	
NAME OF DRILLER	Adron A. Pouncey
DATE WELL COMPLETED	7/26/02

PERMIT NUMBER	
NAME OF DRILLER	Adron A. Pouncey
ADDRESS	10200 Possom Fork Picayune, MS 39466

NAME & MAILING ADDRESS OF LANDOWNER	New - Oak Grove Baptist Church -
Latitude:	
Longitude:	
WELL LOCATION	SEC 1 TOWNSHIP 4 N RANGE 14 E
DISTANCE	Silver Run Rd. NEAREST TOWN
OTHER LANDMARK	Corner of New church by old Aaron Rd.
WELL PURPOSE	Home, Irrigation, Municipal, Industrial, Fish Pond, etc. For church

PUMP DATA					
PUMP TYPE (Circle One):	submersible	Turbine	Jet	Flowing Well	
Other (Describe)					
POWER (Circle One):	Electric	Tractor	Diesel	Gasoline	Butane
Other (Describe)					H/P

DESCRIPTION OF FORMATIONS ENCOUNTERED	FROM	TO
TOP	0	28
SD good	28	85
Clay Bore	85	130
good Brown sd	130	180
Clay junky	180	260
Clay shale junky	260	640
Hard		
Fair to very good	640	710
Bottom		

WELL DATA		
Well Depth	Casing Diameter (In.)	Casing Length (Ft.)
710	4X2	690
Type of Casing	Hole Depth	Depth to Static Water Level
PVC	2710	92'
TYPE OF COMPLETION: (Circle One or More):		
Gravel Packed	Underreamed	Telescoped
Natural Development	Open Hole	Other
(Describe)	+ AIR	

WELL GROUTED TO A DEPTH OF	14/25 FEET
Type Grout (circle one):	Cement, Bentonite or Mix

SCREEN DATA		
Diameter - Inches	Length - Feet	Slot Size - Inches
2	20	10/10/12
Screen Type	Depth to Bottom - Feet	
PVC wrap	710	

RECEIVED
FEB 06 2003
BY: OLWR

Top of Lap Pipe or Reduction in Casing	220 FEET
IF TELESCOPED OR MORE THAN ONE SCREEN: USE BACK PAGE	

I certify that the well was drilled, constructed and completed in accordance with all applicable requirements of the Mississippi Department of Environmental Quality and/or the Mississippi Department of Health regulations and state laws.


Signature of Licensed Driller and License No.

8-602
Rewrite on
2/1/03
Date

Additional Information Required On Back

If well telescopes please sketch and show depths.

GROUND LEVEL

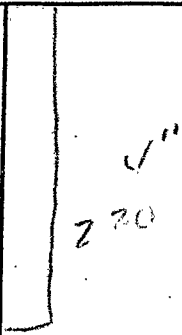

Jeff I read it
 Store Co. map in
 case I ever go back
 up there for fossils
 where he'd put one

Now call it out completely
 corner of Salmon River and
 SECTION _____

Please indicate well location X.

Pump Capacity (GPM)	No. of Stages	Setting Depth
20		120 FT.

PUMP TEST
 Well yielded 26 GPM with
 a drawdown of _____ ft.
 after 200 hours of pumping.

LOG DATA

TYPE OF LOG RUN (Circle One): No Log Run, Electric, Gamma Ray, Density, Sonic, Neutron, Other (Describe) _____

Name of Organization Running Log _____

GEOLOGIC DATA (Office Use Only)

Surface Elev.	Geologic Unit	Unit Thickness	Depth to Top
Subs. SWL	Date	Analysis	Aquifer Test

Driller's Remarks
 Check with good
 well - some at
 as good as I have

If more than one screen, show location of each on sketch.