

Pearl River
 5200
 11-66

MISSISSIPPI
 BOARD OF WATER COMMISSIONERS
 416 North State Street
 Jackson, Mississippi 39201

WATER WELL DRILLERS LOG

11-22 1966 Leo Ladner Pearl River
 date well completed firm name county well located

LANDOWNER: Hester Evans

description of formations encountered	from	to
	Surface	0
Clay	1	3
Sand	3	49

Poplarville, Miss

(mailing address)

WELL LOCATION:

sec. 18 T 4 N R 14 E
 S W
 8 miles SE of Poplarville
 (distance) (direction) (nearest town)

WELL PURPOSE: Home
 (home, irrigation, municipal, industrial)


WELL COMPLETION DATA:

- (1) diameter (inches) 2
- (2) total depth (feet) 49
- (3) static water level (feet) 37 below top of ground.
- (4) casing (material) 44' (depth)
 2" (size) if telescope see back.
- (5) screen 5' (length) (depth to top)
 .008 (size) (material)
- (6) pump (HP) (yield gpm)
 (type power)
- (7) electric log (yes or no)
 (organization running log)
- (8) how well bottom plugged

DRILLERS REMARKS:

If well telescopes please sketch and show depths.

GROUND LEVEL

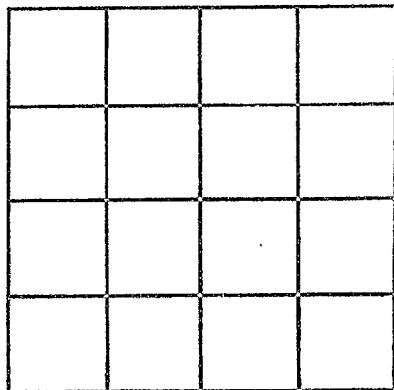

SECTION _____

Please indicate well location X.

ADDITIONAL INFORMATION

If more than one screen, show locations of each on sketch.