

Pearl River
S 2002
11-1-76

MISSISSIPPI
 BOARD OF WATER COMMISSIONERS
 416 North State Street
 Jackson, Mississippi 39201

WATER WELL DRILLERS LOG

11-1 1976 Pennell Anderson Pearl River
 date well completed firm name county well located


LANDOWNER:	description of formations encountered	from	to
<u>Mancy Smith</u>	<u>Top Soil</u>	<u>0</u>	<u>2</u>
(mailing address)	<u>Clay</u>	<u>2</u>	<u>128</u>
WELL LOCATION:	<u>fine sand</u>	<u>120</u>	<u>128</u>
sec <u>22</u> T <u>4</u> N R <u>14</u> E S W	<u>Clay</u>	<u>128</u>	<u>266</u>
<u>12</u> miles <u>SE</u> of <u>Poplarville</u>	<u>fine sand</u>	<u>260</u>	<u>310</u>
(distance) (direction) (nearest town)	<u>course sand</u>	<u>310</u>	<u>336</u>
WELL PURPOSE: <u>170 MI</u> (home, irrigation, municipal, industrial)			
WELL COMPLETION DATA:			
(1) diameter (inches) <u>2"</u>			
(2) total depth (feet) <u>336</u>			
(3) static water level (feet) <u>82'</u> below top of ground.			
(4) casing <u>Plastic 331'</u> (material) (depth)			
(size) If telescope see back.			
(5) screen <u>15'</u> <u>331'</u> (length) (depth to top)			
<u>2"</u> <u>Plastic</u> (size) (material)			
(6) pump <u>1</u> <u>6</u> (HP) (yield gpm)			
<u>Elect</u> (type power)			
(7) electric log <u>no</u> (yes or no)			
(organization running log)			
(8) how well bottom plugged <u>Back wash 120'</u>			
DRILLERS REMARKS:			

RECEIVED
 DEC 10 1976

MISS. BD. OF WATER COMM.

If well telescopes please sketch and show depths.

GROUND LEVEL

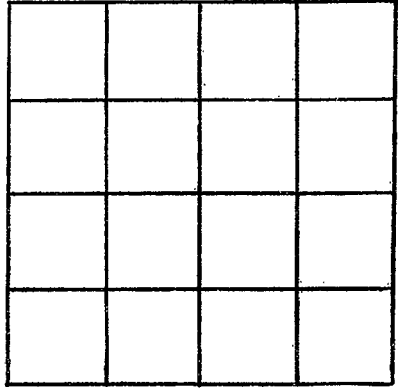

SECTION _____

Please indicate well location X.

ADDITIONAL INFORMATION

If more than one screen, show locations of each on sketch.