

Pearl River
S 2003
4-28-77

MISSISSIPPI
BOARD OF WATER COMMISSIONERS
416 North State Street
138 Jackson, Mississippi 39201

WATER WELL DRILLERS LOG

4-28 19 Pooney Water wells Pearl River
date well completed firm name county well located

LANDOWNER: Ardo Lohm
Rt. Poplarville, MS.
39166
(mailing address)

description of formations encountered	from	to
<u>Clay</u>	<u>0</u>	<u>16</u>
<u>SD</u>	<u>16</u>	<u>34</u>
<u>Clay Blue</u>	<u>34</u>	<u>123</u>
<u>SD</u>	<u>123</u>	<u>131</u>

WELL LOCATION:
sec. 32 T 4 N R 14 E
15 miles S of Pville
(distance) (direction) (nearest town)

WELL PURPOSE: Home
(home, irrigation, municipal, industrial)

- WELL COMPLETION DATA:
- (1) diameter (inches) 2
 - (2) total depth (feet) 131
 - (3) static water level (feet) 78 below above top of ground.
 - (4) casing PVC 73
(material) (depth)
2 if telescope see back.
(size)
 - (5) screen 5 73
(length) (depth to top)
2 PVC
(size) (material)
 - (6) pump 1 6
(HP) (yield gpm)
HC 220
(type power)
 - (7) electric log yes or no
 - (organization running log)
 - (8) how well bottom plugged Seal


DRILLERS REMARKS: good well

RECEIVED
AUG 28 1977

MISS. BD. OF WATER COMMISSIONERS

If well telescopes please sketch and show depths.

GROUND LEVEL

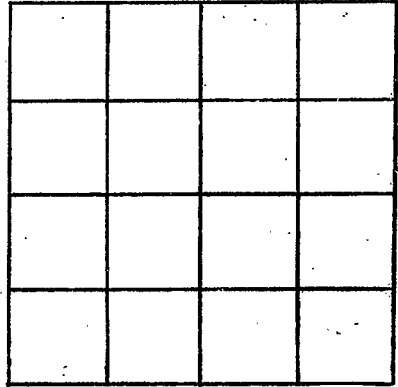

SECTION _____

Please indicate well location X.

ADDITIONAL INFORMATION

If more than one screen, show locations of each on sketch.