

Pearl River
 92004
 5-4-77

MISSISSIPPI
 BOARD OF WATER COMMISSIONERS
 416 North State Street
 135 Jackson, Mississippi 39201

WATER WELL DRILLERS LOG

5-4-77 Pearl River water Pearl River
 date well completed firm name county well located

LANDOWNER: Les Bamette
RFD Poplarville ms
39461
 (mailing address)

WELL LOCATION:
 sec 29 T 4 N R 14 E
13 miles S of Skille
 (distance) (direction) (nearest town)

WELL PURPOSE: Home
 (home, irrigation, municipal, industrial)

- WELL COMPLETION DATA:
- (1) diameter (inches) 2
 - (2) total depth (feet) 274
 - (3) static water level (feet) 100 below above top of ground.
 - (4) casing PVC 269
 (material) (depth)
2 if telescope see back.
 (size)
 - (5) screen 5 269
 (length) (depth to top)
2 PVC
 (size) (material)
 - (6) pump 1 1/2 6
 (HP) (yield gpm)
200 AC
 (type power)
 - (7) electric log
 (yes or no)

(organization running log)
 (8) how well bottom plugged Subd.

DRILLERS REMARKS: well
FAIR-


description of formations encountered	from	to
<u>sd - clay</u>	<u>0</u>	<u>34</u>
<u>slt</u>	<u>34</u>	<u>188</u>
<u>sd - fine clay</u>	<u>188</u>	<u>192</u>
<u>sd - fine</u>	<u>192</u>	<u>200</u>
<u>sd - fine</u>	<u>200</u>	<u>222</u>
<u>sd - fine</u>	<u>222</u>	<u>240</u>
<u>sd - fair</u>	<u>240</u>	<u>274</u>

RECEIVED
 AUG 26 1977

MISSISSIPPI BOARD OF WATER COMMISSIONERS

If well telescopes please sketch and show depths.

GROUND LEVEL

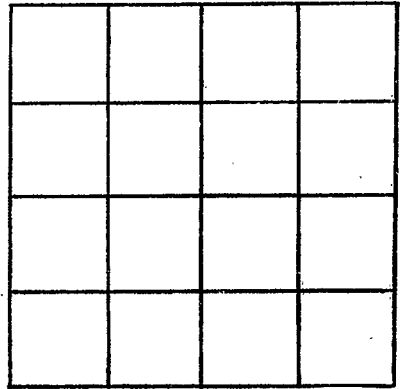

SECTION _____

Please indicate well location X.

ADDITIONAL INFORMATION

If more than one screen, show locations of each on sketch.