

PEARL RIVER  
S 2005

MISSISSIPPI  
BOARD OF WATER COMMISSIONERS  
416 North State Street  
Jackson, Mississippi 39201

WATER WELL DRILLERS LOG

6-1 78 Bud Pentons Son Pearl River  
date well completed firm name county well located

LANDOWNER:  
J W Spitzfaden  
Poplarville Ms.  
(mailing address)

description of formations encountered	from	to
	Red Shale	0
Red Sand	70	110
Blue Shale	110	280
Grey Sand	280	323

WELL LOCATION:  
sec. 8 T 4 N R 14 E  
11 miles E of Popl.  
(distance) (direction) (nearest town)

WELL PURPOSE: Home  
(home, irrigation, municipal, industrial)

WELL COMPLETION DATA:

(1) diameter (inches) 4 in  
(2) total depth (feet) 323  
(3) static water level (feet) 114 below top of ground.  
(4) casing PVC, 323 (material) (depth)  
(size) If telescope see back.  
(5) screen 4x10, 313 (length) (depth to top)  
12 PVC (size) (material)  
(6) pump 1, 650 (HP) (yield gpm)  
electric (type power)  
(7) electric log NO (yes or no)  
(organization running log)

(8) how well bottom plugged Sand Shrub


DRILLERS REMARKS:

RECEIVED  
JUL 31 1978

MISS. BD. OF WATER COMM.

Well telescopes please  
sketch and show depths.

GROUND LEVEL

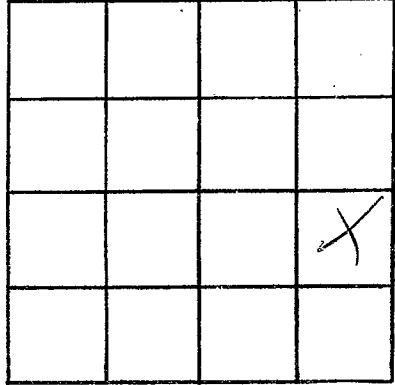

SECTION \_\_\_\_\_

Please indicate well location X.

ADDITIONAL INFORMATION

If more than one screen,  
show locations of each on sketch.