

PEARL RIVER
 S 2000
 2-09-79

MISSISSIPPI
 BOARD OF WATER COMMISSIONERS
 416 North State Street
 Jackson, Mississippi 39201

WATER WELL DRILLERS LOG

2/9 1978 Bud Denton & Son Pearl River
 date well completed firm name county well located

LANDOWNER: Alvin Cartney
 R.T. 4 Box 344
 Poplarville Miss.
 (mailing address)

description of formations encountered	from	to
Red shale	0	21
White shale	21	305
Dry sand	305	340

WELL LOCATION:
 sec. 32 T-4 N R-14 E
 12 miles S of Poplarville
 (distance) (direction) (nearest town)

WELL PURPOSE: Home
 (home, irrigation, municipal, industrial)

WELL COMPLETION DATA:

(1) diameter (inches) 9"

(2) total depth (feet) 340

(3) static water level (feet) 98 below top of ground.

(4) casing PVC 340 (material) (depth)
 (size) If telescope see back.

(5) screen 2x10 330 (length) (depth to top)
 12 PVC (size) (material)

(6) pump 1 1/2 360 (HP) (yield gpm)
 E. ket (type power)

(7) electric log No (yes or no)

(organization running log)


(8) how well bottom plugged Sand shank

DRILLERS REMARKS:

Miss. Board of Water Comm.
 FEB 26 1979
 RECEIVED

If well telescopes please sketch and show depths.

GROUND LEVEL

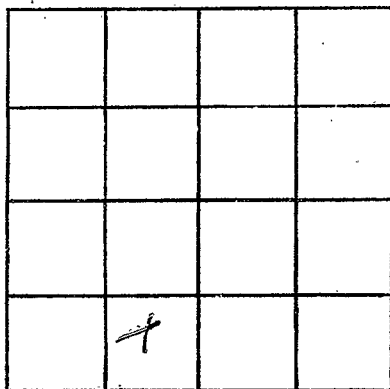

SECTION _____

Please indicate well location X.

ADDITIONAL INFORMATION

If more than one screen,
show locations of each on sketch.