

Pearl River
S2008
9-14-79

MISSISSIPPI
BOARD OF WATER COMMISSIONERS
416 North State Street
Jackson, Mississippi 39201

WATER WELL DRILLERS LOG

9-14 1979 Bradon Pump & Well Pearl River
date well completed firm name county well located
Don Inc

LANDOWNER: Don Baradell
Rt. 2, Box 234
Poplarville, MS
(mailing address)

description of formations encountered	from	to
	clay	0
shale	20	50
clay	50	60
blue clay	60	100
sand	100	140

WELL LOCATION:
sec 26 T 7 N R 14 E
15 miles SE of Poplarville
(distance) (direction) (nearest town)

WELL PURPOSE: Home
(home, irrigation, municipal, industrial)

- WELL COMPLETION DATA:
- (1) diameter (inches) 2"
 - (2) total depth (feet) 140'
 - (3) static water level (feet) 25' below top of ground.
 - (4) casing PVC total
(material) (depth)
2" If telescope see back.
(size)
 - (5) screen 0 ft, 130 ft
(length) (depth to top)
2" 100% PVC underbar
(size) (material)
 - (6) pump 1 (HP) 10 (yield gpm)
110V
(type power)
 - (7) electric log no
(yes or no)
- (organization running log)

(8) how well bottom plugged
2" sand shawl

DRILLERS REMARKS:


DEPT. OF NATURAL RESOURCES
BUREAU OF LAND & WATER RESOURCES

DEC 21 1979

RECEIVED

If well telescopes please sketch and show depths.

GROUND LEVEL

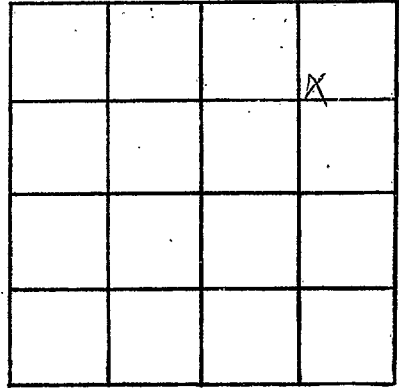

SECTION 26

Please indicate well location X.

ADDITIONAL INFORMATION

If more than one screen, show locations of each on sketch.