

PEARL RIVER
S 2009

MISSISSIPPI
BOARD OF WATER COMMISSIONERS
416 North State Street
Jackson, Mississippi 39201



11/15/80

WATER WELL DRILLERS LOG

61-15 1980

BOUNCY WATER WELL DRILLING

PEARL RIVER

date well completed

firm name

county well located

LANDOWNER: <u>Douglas DuBose</u>	description of formations encountered	from	to
<u>Baeth Community</u> (mailing address)			
WELL LOCATION: sec. <u>22</u> T <u>4</u> N R <u>14</u> E <u>5</u> miles <u>SE</u> of <u>Silver</u> (distance) (direction) (nearest town)	<u>top clay</u>	<u>0</u>	<u>0</u>
WELL PURPOSE: <u>Home</u> (home, irrigation, municipal, industrial)	<u>gravel - sh. sd.</u>	<u>0</u>	<u>50</u>
WELL COMPLETION DATA: (1) diameter (inches) <u>2</u> (2) total depth (feet) <u>60</u> (3) static water level (feet) <u>38</u> below above top of ground. (4) casing <u>PVC</u> <u>33</u> (material) (depth) <u>2</u> if telescope see back. (size) (5) screen <u>5</u> <u>33</u> (length) (depth to top) <u>2</u> <u>PVC</u> (size) (material) (6) pump <u>1</u> <u>10</u> (HP) (yield gpm) <u>AC</u> (type power) (7) electric log <u>/</u> (yes or no) <u>/</u> (organization running log) (8) how well bottom plugged <u>/</u>	<u>50</u>	<u>60</u>	

DRILLERS REMARKS:


DEPT. OF NATURAL RESOURCES
BUREAU OF LAND & WATER RESOURCES

MAR 18 1981

RECEIVED

If well telescopes please sketch and show depths.

GROUND LEVEL

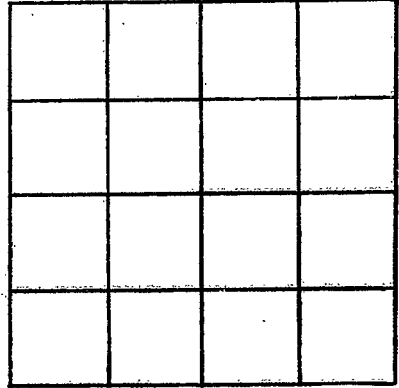

SECTION _____

Please indicate well location X.

ADDITIONAL INFORMATION

If more than one screen, show locations of each on sketch.