

PEARL RIVER  
S 2010  
7/31/80  
7-31

MISSISSIPPI  
BOARD OF WATER COMMISSIONERS  
416 North State Street  
Jackson, Mississippi 39201



WATER WELL DRILLERS LOG  
DOWNEY WATER WELL DRILLING

LANDOWNER:	description of formations encountered	from	to
Robert Lee RED Poplarville	Top	0	12
(mailing address)	sd - dry	12	26
WELL LOCATION: sec 16 T 4 N R 14 E 4 miles SE of Silver Run	Brk Clay	26	40
(distance) (direction) (nearest town)	Clay & Pink slty	40	240
WELL PURPOSE: Home	sd & mifed.	240	340
(home, irrigation, municipal, industrial)	Good sd.	227	340
WELL COMPLETION DATA:			
(1) diameter (inches) 2			
(2) total depth (feet) 340			
(3) static water level (feet) 12 1/2 below top of ground			
(4) casing PVC 330 (material) (depth)			
2 (size) if telescope see back.			
(5) screen 10 330 (length) (depth to top)			
2 PVC (size) (material)			
(6) pump 1 1/2 10 (HP) (yield gpm)			
AC (type power)			
(7) electric log (yes or no)			
(organization running log)			
(8) how well bottom plugged Sealed			
DRILLERS REMARKS:			


DEPT. OF NATURAL RESOURCES  
BUREAU OF LAND & WATER RESOURCES

MAR 13 1981

RECEIVED

If well telescopes please sketch and show depths.

GROUND LEVEL

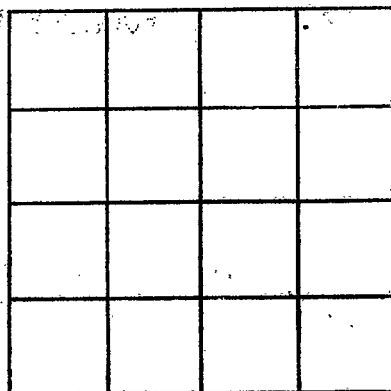

SECTION \_\_\_\_\_

Please indicate well location X.

ADDITIONAL INFORMATION

If more than one screen, show locations of each on sketch.