

Pearl River  
S 2012  
11/28/81

MISSISSIPPI DEPARTMENT OF NATURAL RESOURCES  
Bureau of Land and Water Resources  
Southport Mall  
P.O. Box 10631  
Jackson, Mississippi 39209  
WATER WELL DRILLERS LOG

11/28 1981 - BRADEN Pump & Well PEARL RIVER  
date well completed firm name county well located  
SERVICE, INC.

LANDOWNER: DWAYNE PETERSON  
RT. 4 Box 307  
Poplarville, Ms. 39470  
(mailing address)

description of formations encountered	from	to
CLAY	0	20
CLAY + SAND	20	60
CLAY	60	150
SAND	150	170
CLAY	170	180

WELL LOCATION: STEEP HOLLOW  
sec. 32 T. 4 N. R. 14 E  
S W  
1 miles S.E. of STEEP HOLLOW  
(distance) (direction) (nearest town)

WELL PURPOSE: HOME  
(home, irrigation, municipal, industrial)

WELL COMPLETION DATA:

(1) diameter (inches) 2"

(2) total depth (feet) 180

(3) static water level (feet) 107 below top of ground.

(4) casing PVC total  
(material) (depth)  
2" if telescope see back.  
(size)

(5) screen 10' 160'  
(length) (depth to top)  
2" PVC underbar  
(size) (material)

(6) pump 1 (20g) 6  
(HP) (yield gpm)  
220V-1Ø  
(type power)

(7) electric log No  
(yes or no)

(organization running log)

(8) how well bottom plugged  
BACK w/ 5th check

DRILLERS REMARKS:  
10 ft tailpipe.


DEPT. OF NATURAL RESOURCES  
BUREAU OF LAND & WATER RESOURCES

DEC - 7 1981

RECEIVED

If well telescopes please sketch and show depths.

GROUND LEVEL

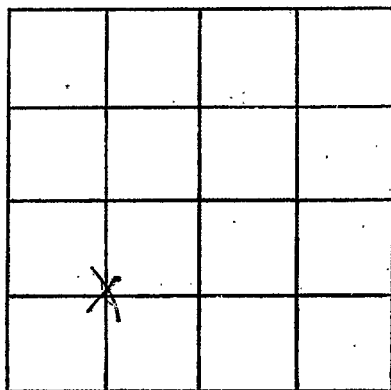

SECTION 32

Please indicate well location X.

ADDITIONAL INFORMATION

If more than one screen,  
show locations of each on sketch.