

MISSISSIPPI DEPARTMENT OF NATURAL RESOURCES

Bureau of Land and Water Resources

Southport Mall

P.O. Box 10631

Jackson, Mississippi 39209

WATER WELL DRILLERS LOG

Pearl River
S
2014

date well completed 5-25-82 well name Pouney water well, Pearl River
firm name Pinberg county well located

LANDOWNER: Michael C. Smith - Rt. Poplarville
Hg 53
(mailing address)

description of formations encountered	from	to
<u>Top</u>	<u>0</u>	<u>8</u>
<u>SD - Slt. Clay</u>	<u>8</u>	<u>66</u>
<u>Clay</u>	<u>66</u>	<u>72</u>
<u>SD</u>	<u>72</u>	<u>83</u>
<u>Clay</u>	<u>83</u>	<u>110</u>
<u>SD</u>	<u>110</u>	<u>135</u>
<u>Shale</u>	<u>135</u>	<u>221</u>
<u>SD w/ sp.</u>	<u>221</u>	<u>251</u>
<u>SD Wood</u>	<u>251</u>	<u>270</u>

WELL LOCATION:
sec. 30 T. 4 N. R. 14 E. S. 5 W.
16 miles S of Poplarville
(distance) (direction) (nearest town)

WELL PURPOSE: Home
(home, irrigation, municipal, industrial)

- WELL COMPLETION DATA:
- (1) diameter (inches) 4
 - (2) total depth (feet) 275
 - (3) static water level (feet) 159 below top of ground
 - (4) casing Pvc 260
(material) (depth)
4 (size) if telescope see back.
 - (5) screen 15, 260
(length) (depth to top)
4 (size) Pvc (material)
 - (6) pump 1/2 20
(HP) (yield gpm)
230 V AC (type power)
 - (7) electric log (yes or no) /
(organization running log) Seal
 - (8) how well bottom plugged Seal


DRILLERS REMARKS:

DEPT. OF NATURAL RESOURCES
BUREAU OF LAND & WATER RESOURCES

JUN - 1 1982
RECEIVED

If well telescopes please sketch and show depths.

GROUND LEVEL

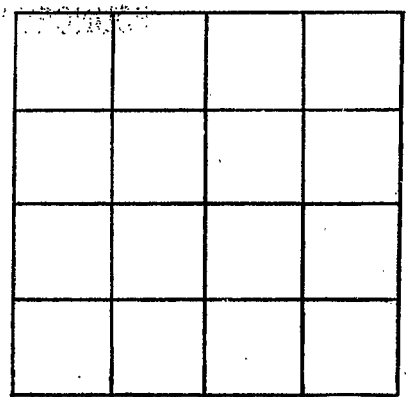

SECTION _____

Please indicate well location X.

ADDITIONAL INFORMATION

A series of horizontal lines for recording additional information, starting below the 'ADDITIONAL INFORMATION' header.

If more than one screen, show locations of each on sketch.