

MISSISSIPPI DEPARTMENT OF NATURAL RESOURCES

Bureau of Land and Water Resources

Southport Mall

P.O. Box 10631

Jackson, Mississippi 39209

WATER WELL DRILLERS LOG

Pearl River
5
2015


avg 5 - 82 Walburn Welding Pearl River
 date well completed firm name county well located

LANDOWNER: <u>Betty v Jensen</u>	description of formations encountered	from	to
<u>PO Box 70</u>	<u>Red sand shale</u>	<u>0</u>	<u>36</u>
<u>Poplarville Miss</u> (mailing address)	<u>Coarse sand fine gravel</u>	<u>36</u>	<u>57</u>
WELL LOCATION:			
sec. <u>7</u> T <u>4</u> N R <u>14</u> W			
<u>1.4</u> miles <u>SE</u> <u>Poplarville</u> (distance) (direction) (nearest town)			
WELL PURPOSE: <u>home</u> (home, irrigation, municipal, industrial)			
WELL COMPLETION DATA:			
(1) diameter (inches) <u>2"</u>			
(2) total depth (feet) <u>57</u>			
(3) static water level (feet) <u>45</u> <u>below</u> above top of ground.			
(4) casing <u>steel</u> <u>52</u> (material) (depth)			
(size) if telescope see back.			
(5) screen <u>5'</u> <u>52</u> (length) (depth to top)			
<u>60</u> <u>garn</u> (size) (material)			
(6) pump <u>1</u> <u>7</u> (HP) (yield gpm)			
<u>Elec</u> (type power)			
(7) electric log (yes or no)			
(organization running log)			
(8) how well bottom plugged <u>hard</u> <u>sharp</u>			
DRILLERS REMARKS:			

DEPT. OF NATURAL RESOURCES
 BUREAU OF LAND & WATER RESOURCES
 AUG 23 1982
RECEIVED

If well telescopes please
sketch and show depths.

GROUND LEVEL

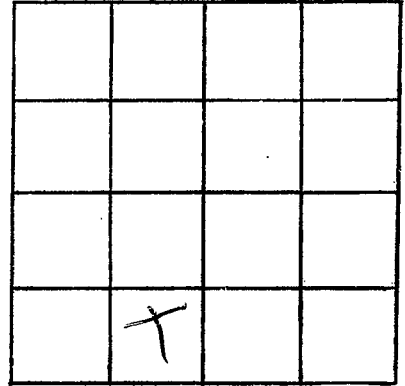

SECTION _____

Please indicate well location X.

ADDITIONAL INFORMATION

If more than one screen,
show locations of each on sketch.