

Real River
Scott

MISSISSIPPI
BOARD OF WATER COMMISSIONERS
416 North State Street
Jackson, Mississippi 39201

WATER WELL DRILLERS LOG

Real River
Store

Aug 11 1992
date well completed

92 Farnell Anderson
firm name

county well located

LANDOWNER	description of formations encountered	from	to
Maxine Steiner Rt 4	top soil	0	2
Derbinston, MS (mailing address)	clay sand	2	21
WELL LOCATION: sec. 14 T. 4 N. R. 14 E. S. 5 14 miles SE of Poplarville	clay sand	21	37
WELL PURPOSE: home (home, irrigation, municipal, industrial)		37	105
WELL COMPLETION DATA: (1) diameter (inches) 2"		105	128
(2) total depth (feet) 128'			
(3) static water level (feet) 60' below top of ground.			
(4) casing P.V.C. (material), (depth)			
(size) If telescope see back.			
(5) screen 5' length, 123' depth to top 2" (size), P.V.C. (material)			
(6) pump 1 (HP), 9 (yield gpm) Electric (type power)			
(7) electric log NO (yes or no)			
(organization running log)			
(8) how well bottom plugged Capped			
DRILLERS REMARKS:			


DEPT. OF NATURAL RESOURCES
BUREAU OF LAND & WATER RESOURCES

SEP 21 1992

RECEIVED

If well telescopes please sketch and show depths.

GROUND LEVEL

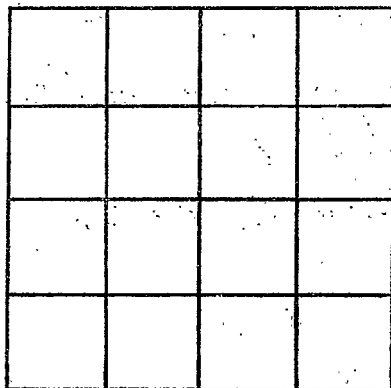

SECTION _____

Please indicate well location X.

ADDITIONAL INFORMATION

If more than one screen, show locations of each on sketch.