

MISSISSIPPI DEPARTMENT OF NATURAL RESOURCES
Bureau of Land and Water Resources
 Southport Mall
 P.O. Box 10631
 Jackson, Mississippi 39209
WATER WELL DRILLERS LOG

Pearl Rider
50018

6/9 1983 Subparton Pearl Rider
 date well completed firm name county well located

LANDOWNER: Jaden King description of formations encountered: Red shale
Red sand
Red clay
Red sand
 from to
0 21
21 58
Pat. 4 Box 1107A
Poplarville miss
 (mailing address)

WELL LOCATION:
 sec. 7 T. 4 N R. 14 E
S W
8.7 miles South of Poplarville
 (distance) (direction) (nearest town)

WELL PURPOSE: None
 (home, irrigation, municipal, industrial)

- WELL COMPLETION DATA:
- (1) diameter (inches) 12"
 - (2) total depth (feet) 58 ft
 - (3) static water level (feet) 22 below above top of ground.
 - (4) casing pvc, 58
 (material) (depth)
 if telescope see back.
 (size)
 - (5) screen 10 ft, 48
 (length) (depth to top)
12, pvc
 (size) (material)
 - (6) pump 1/2, 800
 (HP) (yield gpm)
Elect
 (type power)
 - (7) electric log no
 (yes or no)

 (organization running log)


(8) how well bottom plugged Seal

DRILLERS REMARKS: Shark

DEPT. OF NATURAL RESOURCES
 BUREAU OF LAND & WATER RESOURCES
 JUL 26 1983
RECEIVED

If well telescopes please sketch and show depths.

GROUND LEVEL

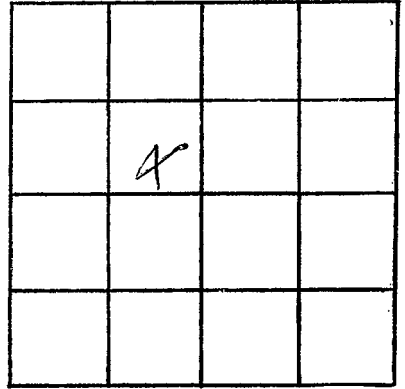

SECTION _____

Please indicate well location X.

ADDITIONAL INFORMATION

If more than one screen,
show locations of each on sketch.