

MISSISSIPPI DEPARTMENT OF NATURAL RESOURCES

BUD PENTON & SON Bureau of Land and Water Resources

WATER WELL SERVICE

ROUTE 4 BOX 404

CARRIERE, MS 39223

PHONE 799-6824

Southport Mall

P.O. Box 10631

Jackson, Mississippi 39209

BUD PENTON & SON

WATER WELL SERVICE

ROUTE 4 BOX 404

CARRIERE, MS 39223

PHONE 799-6824

WATER WELL DRILLERS LOG

Paul Brees
 S S
 209

12/2

19

83

date well completed

firm name

Paul Brees
 county well located

LANDOWNER:

Bruce Bibb

A.T. 3 P. Carriere Mrs.

(mailing address)

description of formations encountered

from

to

Red shale

0

32

Red sand

32

86

Blue shale

86

210

Grey sand

210

265

WELL LOCATION:

sec. 1 T. 4 N. R. 14 E. S. W.

12 miles East of Carriere
 (distance) (direction) (nearest town)

WELL PURPOSE:

Home

(home, irrigation, municipal, industrial)

WELL COMPLETION DATA:

- (1) diameter (inches) 2
- (2) total depth (feet) 265
- (3) static water level (feet) 65 below top of ground.

- (4) casing PVC, 265,
 (material) (depth)

(size) if telescope see back.

- (5) screen 10, 253
 (length) (depth to top)

10, PVC
 (size) (material)

- (6) pump no
 (HP) (yield gpm)

(type power)

- (7) electric log _____
 (yes or no)

(organization running log)

- (8) how well bottom plugged Sand
There

DRILLERS REMARKS:

*no pump
 finished*


DEPT. OF NATURAL RESOURCES
 BUREAU OF LAND & WATER RESOURCES

MAR 23 1984

RECEIVED

If well telescopes please
sketch and show depths.

GROUND LEVEL

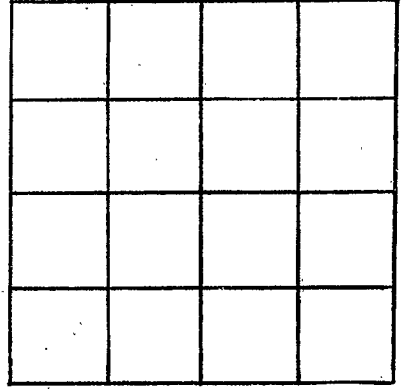

SECTION _____

Please indicate well location X.

ADDITIONAL INFORMATION

If more than one screen,
show locations of each on sketch.