

*Pearl River*  
 S  
 2020  
 7-10

MISSISSIPPI DEPARTMENT OF NATURAL RESOURCES

Bureau of Land and Water Resources

Southport Mall

P.O. Box 10631

Jackson, Mississippi 39209

WATER WELL DRILLERS LOG

BOUNCY WATER WELL DRILLING, Pearl River

date well completed

firm name

county well located

LANDOWNER:

*Dale Harnel*  
*Poplarville Pt.*

description of formations encountered

from

to

(mailing address)

WELL LOCATION:

sec 16 T 4 N R 14 E  
 (distance) miles (direction) of Steep (nearest town)

*Top* 0 26  
*SD junk* 26 72  
*clay* 72 28  
*SD 1/2 in* 280 365  
*SD fine to fair* 350 365

WELL PURPOSE:

(home, irrigation, municipal, industrial)

*Home*

WELL COMPLETION DATA:

- (1) diameter (inches) 2
- (2) total depth (feet) 365
- (3) static water level (feet) 100 below above top of ground
- (4) casing PVC 350  
 (material) (depth)
- 2 if telescope see back.  
 (size)
- (5) screen 15 350  
 (length) (depth to top)
- 2 PVC  
 (size) (material)
- (6) pump 1 HP  
 (HP) (yield gpm)
- PC  
 (type power)
- (7) electric log \_\_\_\_\_  
 (yes or no)
- \_\_\_\_\_ (organization running log)
- (8) how well bottom plugged \_\_\_\_\_

DEPT. OF NATURAL RESOURCES  
 BUREAU OF LAND & WATER RESOURCES


SEP 10 1984

RECEIVED

DRILLERS REMARKS:

If well telescopes please sketch and show depths.

GROUND LEVEL

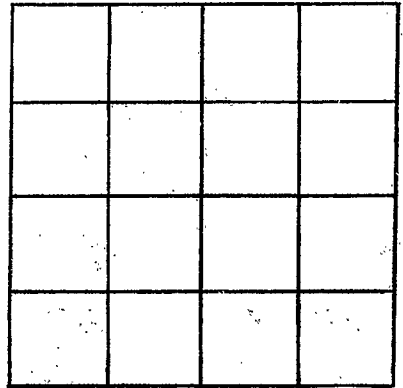

SECTION \_\_\_\_\_

Please indicate well location X.

ADDITIONAL INFORMATION

A series of horizontal lines providing space for additional information.

If more than one screen, show locations of each on sketch.