

MISSISSIPPI DEPARTMENT OF NATURAL RESOURCES

Bureau of Land and Water Resources

Southport Mall

P.O. Box 10631

Jackson, Mississippi 39209

WATER WELL DRILLERS LOG

Pearl River
S 2001

2-7 1985
date well completed

SPOUNCEY WATER WELL DRILLING
firm name

Pearl River
county well located


LANDOWNER: <u>Floyd Hatten</u> <u>Booth Community</u>	description of formations encountered	from	to
(mailing address)	<u>TOP</u> <u>SD</u>	<u>@</u>	<u>18</u> <u>26</u>
WELL LOCATION: sec. <u>16</u> T. <u>4</u> N. R. <u>14</u> E. <u>1 1/2</u> miles <u>N/E</u> of <u>Stamps Hollow Church</u> (distance) (direction) (nearest town)	<u>Clay</u> <u>SPT to SD</u>	<u>26</u>	<u>296</u> <u>383</u>
WELL PURPOSE: <u>Home</u> (home, irrigation, municipal, industrial)			
WELL COMPLETION DATA:			
(1) diameter (inches) <u>2</u>			
(2) total depth (feet) <u>378</u>			
(3) static water level (feet) <u>104</u> below above top of ground.			
(4) casing <u>PVC</u> <u>368</u> (material) (depth) <u>2</u> if telescope see back. (size)			
(5) screen <u>10</u> <u>368</u> (length) (depth to top) <u>2</u> <u>PVC</u> (size) (material)			
(6) pump <u>1 1/4</u> <u>6</u> (HP) (yield gpm) <u>AC</u> (type power)			
(7) electric log _____ (yes or no)			
_____ (organization running log)			
(8) how well bottom plugged _____			
DRILLERS REMARKS:			

RECEIVED
FEB 25 1985

Department of Natural Resources
Bureau of Land & Water Resources

If well telescopes please
sketch and show depths.

GROUND LEVEL

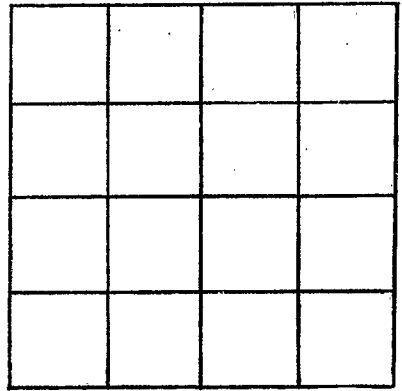

SECTION _____

Please indicate well location X.

ADDITIONAL INFORMATION

If more than one screen,
show locations of each on sketch.