

# MISSISSIPPI DEPARTMENT OF NATURAL RESOURCES

Bureau of Land and Water Resources

COUNTY WELL LOCATED  
**HEARCE RIVER**

WELL NUMBER  
**S**

CODED

DATE WELL COMPLETED  
**3-5-87**

PERMIT NUMBER

**POINCEY WATER WELL DRILLING**

NAME OF DRILLING FIRM  
**ROUTE 3, BOX 461**

**PICAYUNE, MS. 39466**

P.O. Box 10631

Jackson, Mississippi 39209

WATER WELL DRILLERS LOG

NAME & MAILING ADDRESS OF LANDOWNER  
**Mr. Brunner**  
**Booth Land**  
**Development - int. Right**  
**Post cross Rd.**

WELL LOCATION: SEC **27** TOWNSHIP **4 N** RANGE **14 E**

DISTANCE **2 1/2** Miles DIRECTION **E** of NEAREST TOWN **Stark**

OTHER LANDMARK  
**int. Right post Booth**  
**cross Rd.**

WELL PURPOSE **Home Irrigation; Municipal, Industrial, Fish Pond, etc.**

**PUMP DATA**

PUMP TYPE (Circle One):  
Submersible, Turbine, **Jet** Flowing Well,  
Other (Describe) \_\_\_\_\_

POWER TYPE (Circle One):  
Electric, Tractor, Diesel, Gasoline, Butane,  
Other (Describe) \_\_\_\_\_

Pump Capacity (GPM) No. of Stages Setting Depth  
**2** **120** FT.

PUMP TEST

Well yielded **4** GPM with  
a drawdown of \_\_\_\_\_ ft.  
after \_\_\_\_\_ hours of pumping

**WELL DATA**

Well Depth <b>354</b>	Casing Diameter (In.) <b>2</b>	Casing Length (Ft.) <b>304</b>
Type of Casing <b>PVC</b>	Hole Depth <b>354</b>	Depth to Static Water Level <b>9'2"</b>

TYPE OF COMPLETION: (Circle One or More):  
Gravel Packed, Underreamed, Telescoped,  
**Natural Development**, Open Hole, Other

Top of Lap Pipe or Reduction in Casing  
FEET IF TELESOPED OR MORE THAN ONE SCREEN: USE BACK PAGE

**LOG DATA**

TYPE OF LOG RUN (Circle One):  
No Log Run, Electric, Gamma Ray, Density, Sonic, Neutron,  
Other (Describe) \_\_\_\_\_

Name of Organization Running Log

**SCREEN DATA**

Diameter - Inches <b>2</b>	Length - Feet <b>10</b>	Slot Size - Inches <b>008</b>
Screen Type <b>PVC wrap</b>	Depth to Bottom - Feet <b>354</b>	

**GEOLOGIC DATA (Office Use Only)**

Surface Elev.	Geologic Unit	Unit Thickness	Depth to Top
Subs. SWL	Date	Analysis	Aquifer Test

Driller's Remarks

DESCRIPTION OF FORMATIONS ENCOUNTERED	FROM	TO	FORMATIONS (Continued)	FROM	TO
<b>Top</b>	<b>0</b>	<b>16</b>	<b>RECEIVED</b> <b>AUG 10 1987</b> Department of Natural Resources Bureau of Land & Water Resources		<b>354</b>
<b>SD</b>	<b>16</b>	<b>30</b>			
<b>Clay</b>	<b>30</b>	<b>158</b>			
<b>SD Brown</b>	<b>158</b>	<b>209</b>			
<b>Clay</b>	<b>209</b>	<b>302</b>			


IF MORE SPACE IS NEEDED, USE BACK

If well telescopes please  
sketch and show depths.

---

GROUND LEVEL

---

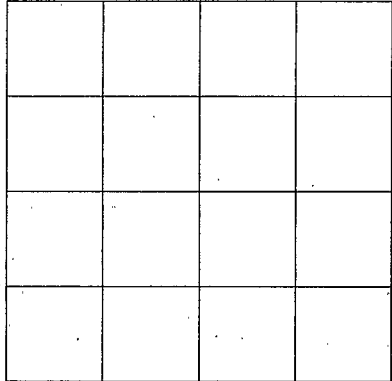

SECTION \_\_\_\_\_

Please indicate well location X.

---

ADDITIONAL INFORMATION

---

If more than one screen,  
show location of each on sketch.

---