

MISSISSIPPI DEPARTMENT OF NATURAL RESOURCES

Bureau of Land and Water Resources

Southport Mall

P.O. Box 10631

Jackson, Mississippi 39209

WATER WELL DRILLERS LOG

Pearl River
52000

3/22 1988 Bed Petro Pearl River
 date well completed firm name county well located

LANDOWNER: T & B Const Co
6063 Louisiana St.
New Orleans La
 (mailing address) 70124

description of formations encountered	from	to
	<u>Red shale</u>	<u>0</u>
<u>wh. sand</u>	<u>22</u>	<u>60</u>
<u>Blue shale</u>	<u>60</u>	<u>140</u>
<u>gray sand</u>	<u>140</u>	<u>192</u>

WELL LOCATION:
 sec. 1 T. 4 N. R. 14 E
14 miles East of Poplarville
 (distance) (direction) (nearest town)

WELL PURPOSE: home
 (home, irrigation, municipal, industrial)

WELL COMPLETION DATA:

- (1) diameter (inches) 4"
- (2) total depth (feet) 192
- (3) static water level (feet) 6 below above top of ground.
- (4) casing pc 192
 (material) (depth)
4x2 if telescope see back.
 (size)
- (5) screen 10 182
 (length) (depth to top)
12 pc
 (size) (material)
- (6) pump 1 18
 (HP) (yield gpm)
Elect.
 (type power)
- (7) electric log no
 (yes or no)

(organization running log)

(8) how well bottom plugged filled

DRILLERS REMARKS:


RECEIVED

APR 29 1988

Department of Natural Resources
 Bureau of Land & Water Resources

If well telescopes please sketch and show depths.

GROUND LEVEL

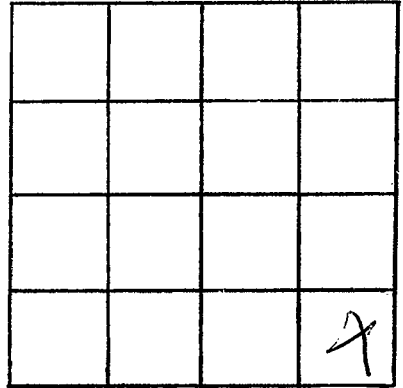

SECTION _____

Please indicate well location X.

ADDITIONAL INFORMATION

If more than one screen,
show locations of each on sketch.