

MISSISSIPPI DEPARTMENT OF NATURAL RESOURCES

Bureau of Land and Water Resources

Southport Mall

P.O. Box 10631

Jackson, Mississippi 39209

WATER WELL DRILLERS LOG

P. River  
S 2009

11/20/88  
date well completed

Clear Water Pullage  
firm name

Pearl River  
county well located

LANDOWNER: ~~Phil Douglas~~  
Dean Forge  
S 209 Bradley Pt.  
Mobile (mailing address) 30003  
WELL LOCATION:  
sec. 27 T. 4 N. R. 14 E  
S W  
8 miles E of Poplarville  
(distance) (direction) (nearest town)

description of formations encountered	from	to
<u>Top Soil</u>	<u>0</u>	<u>3'</u>
<u>Sand &amp; Clay mix</u>	<u>3</u>	<u>11'</u>
<u>med. conc. Red Sand</u>	<u>10</u>	<u>24'</u>
<u>tan to Black Clay</u>	<u>29</u>	<u>30'</u>
<u>Blue Clay</u>	<u>30</u>	<u>300</u>
<u>tan Clay</u>	<u>300</u>	<u>305</u>
<u>med. fine tan sand</u>	<u>305</u>	<u>320</u>
<u>med. to coarse tan sand</u>	<u>320</u>	<u>330</u>

WELL PURPOSE: Home  
(home, irrigation, municipal, industrial)

WELL COMPLETION DATA:

(1) diameter (inches) 2

(2) total depth (feet) 340'

(3) static water level (feet) 80 below above top of ground.

(4) casing PVC 330  
(material) (depth)  
\_\_\_\_\_ If telescope see back.  
(size)

(5) screen 10 330  
(length) (depth to top)  
017 PVC Slit  
(size) (material)

(6) pump 1 6  
(HP) (yield gpm)  
230V  
(type power)

(7) electric log \_\_\_\_\_  
(yes or no)  
\_\_\_\_\_  
(organization running log)

(8) how well bottom plugged SS

RECEIVED


FEB 10 1989

Department of Natural Resources  
Bureau of Land & Water Resources

DRILLERS REMARKS:

If well telescopes please sketch and show depths.

GROUND LEVEL

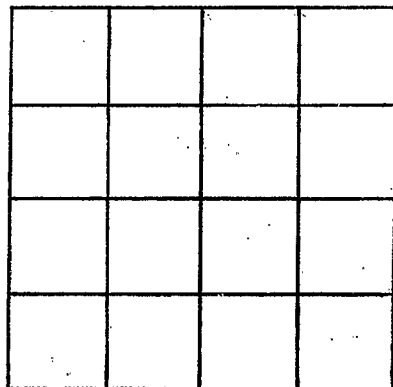

SECTION \_\_\_\_\_

Please indicate well location X.

ADDITIONAL INFORMATION

If more than one screen, show locations of each on sketch.