

MISSISSIPPI DEPARTMENT OF NATURAL RESOURCES

Bureau of Land and Water Resources

Southport Mall

P.O. Box 10631

Jackson, Mississippi 39209

WATER WELL DRILLERS LOG

P. RIVER  
S 2007

4/15 1989 Bud Penton Pearl River  
date well completed firm name county well located

LANDOWNER: Daryl Martin  
R.T. 2 Box 467 D  
Carrier Miss 39426  
(mailing address)

description of formations encountered	from	to
	<u>White shell</u>	<u>0</u>
<u>White sand</u>	<u>135</u>	<u>160</u>
<u>Blue shell</u>	<u>160</u>	<u>208</u>
<u>Gray sand</u>	<u>200</u>	<u>450</u>
<u>Blue shale</u>	<u>450</u>	<u>840</u>
<u>Gray sand</u>	<u>840</u>	<u>912</u>

WELL LOCATION:  
sec. 4 T N R. 14 E  
12 miles East of Carrier  
(distance) (direction) (nearest town)

WELL PURPOSE: home  
(home, irrigation, municipal, industrial)

- WELL COMPLETION DATA:
- (1) diameter (inches) 4"
  - (2) total depth (feet) 912
  - (3) static water level (feet) 115 below above top of ground.
  - (4) casing PVC, 812  
(material) (depth)
  - 4 1/2 If telescope see back.  
(size)
  - (5) screen 15, 897  
(length) (depth to top)
  - 12, PVC  
(size) (material)
  - (6) pump 2, 27  
(HP) (yield gpm)
  - Elect  
(type power)
  - (7) electric log no  
(yes or no)

(organization running log)

(8) how well bottom plugged hard  
sharp

DRILLERS REMARKS:

RECEIVED


MAY 24 1989

Department of Natural Resources  
Bureau of Land & Water Resources

If well telescopes please sketch and show depths.

GROUND LEVEL

7/12 ~~12~~ 2" | 200 4"

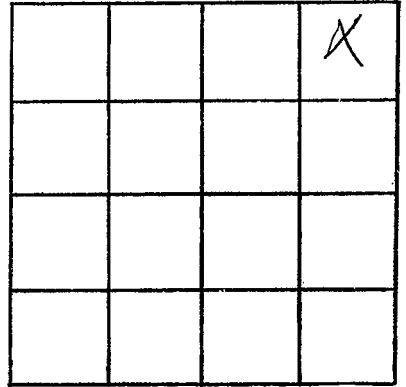

SECTION \_\_\_\_\_

Please indicate well location X.

ADDITIONAL INFORMATION

If more than one screen, show locations of each on sketch.