

MISSISSIPPI DEPARTMENT OF NATURAL RESOURCES

Bureau of Land and Water Resources

Southport Mall

P.O. Box 10631

Jackson, Mississippi 39209

WATER WELL DRILLERS LOG

P. RIVER
S 2030

7/12

19

89 Bud Penton & Sons

Harrold

date well completed

firm name

county well located

LANDOWNER: Boj Smith

description of formations encountered

from

to

Step Hollow Road

Red Shale

0 14

S 603

Red Sand

14 261

(mailing address)

Blue Shale

261 290

Grey Sand

290 415

WELL LOCATION:

sec 29 T 4 N R 14 E
S W

12 miles East Harrold
(distance) (direction) (nearest town)

WELL PURPOSE: Home
(home, irrigation, municipal, industrial)

WELL COMPLETION DATA:

(1) diameter (inches) 4"

(2) total depth (feet) 415

(3) static water level (feet) 92 below above top of ground.

(4) casing PVC, 415
(material) (depth)

4x2 if telescope see back.
(size)

(5) screen 10, 406
(length) (depth to top)

12, PVC
(size) (material)

(6) pump 1, 860
(HP) (yield gpm)

Electric
(type power)

(7) electric log NO
(yes or no)

(organization running log)

(8) how well bottom plugged Hard
Shard

DRILLERS REMARKS:

RECEIVED

JAN 26 1990


Department of Natural Resources
Bureau of Land & Water Resources

If well telescopes please sketch and show depths.

GROUND LEVEL

200ft 4"

215ft 2"

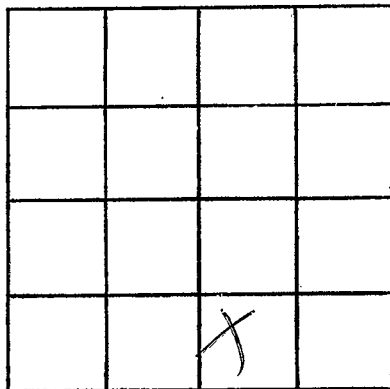

SECTION _____

Please indicate well location X.

ADDITIONAL INFORMATION

If more than one screen,
show locations of each on sketch.