

MISSISSIPPI DEPARTMENT OF ENVIRONMENTAL QUALITY

Office of Land and Water Resources

P. O. Box 10631
Jackson, MS 39289-0631
WATER WELL DRILLERS LOG

COUNTY WELL LOCATED <i>Pearl River</i>	
WELL NUMBER <i>S 2035</i>	CODED
DATE WELL COMPLETED <i>7-10-95</i>	

PERMIT NUMBER
NAME OF DRILLING FIRM <i>Boone's Water Well</i>

NAME & MAILING ADDRESS OF LANDOWNER <i>John Silver</i>		
WELL LOCATION: SEC <i>27</i> TOWNSHIP <i>4</i> RANGE <i>N 14 E</i>		
DISTANCE _____ Miles	DIRECTION _____	NEAREST TOWN _____
OTHER LANDMARK		
WELL PURPOSE: <input checked="" type="checkbox"/> Home Irrigation, Municipal, Industrial, Fish Pond, etc.		

PUMP DATA		
PUMP TYPE (Circle One): Submersible, Turbine, Jet, Flowing Well, Other (Describe) _____		
POWER TYPE (Circle One): Electric, Tractor, Diesel, Gasoline, Butane, Other (Describe) _____ H/P _____		
Pump Capacity (GPM)	No. of Stages	Setting Depth _____ FT.
PUMP TEST		
Well yielded _____ GPM with a drawdown of _____ ft. after _____ hours of pumping		

WELL DATA		
Well Depth <i>80</i>	Casing Diameter (In.) <i>2</i>	Casing Length (Ft.) <i>70</i>
Type of Casing <i>sch 40</i>	Hole Depth <i>80</i>	Depth to Static Water Level

LOG DATA	
TYPE OF LOG RUN (Circle One): No Log Run, Electric, Gamma Ray, Density, Sonic, Neutron, Other (Describe) _____	
Name of Organization Running Log	

TYPE OF COMPLETION: (Circle One or More):
 Gravel Packed, Underreamed, Telescoped, Natural Development, Open Hole, Other (Describe) _____

WELL GROUTED TO A DEPTH OF *5* FEET
 Type Grout (circle one): Cement, Bentonite, or Mix

GEOLOGIC DATA (Office Use Only)			
Surface Elev.	Geologic Unit	Unit Thickness	Depth to Top
Subs. SWL	Date	Analysis	Aquifer Test

SCREEN DATA		
Diameter - Inches <i>2</i>	Length - Feet <i>10</i>	Slot Size - Inches <i># 8</i>
Screen Type <i>sch 40</i>	Depth to Bottom - Feet	


Driller's Remarks <i>Set casing only</i>
Top of Lap Pipe or Reduction in Casing FEET IF TELESKOPED OR MORE THAN ONE SCREEN: USE BACK PAGE

DESCRIPTION OF FORMATIONS ENCOUNTERED	FROM	TO
<i>Clay</i>	<i>0</i>	<i>15</i>
<i>Sand</i>	<i>15</i>	<i>80</i>

FORMATIONS (Continued)	FROM	TO
RECEIVED		
JAN 29 1996		
Dept. of Environmental Quality Office of Land & Water Resources		
IF MORE SPACE IS NEEDED, USE BACK		

If well telescopes please
sketch and show depths.

GROUND LEVEL

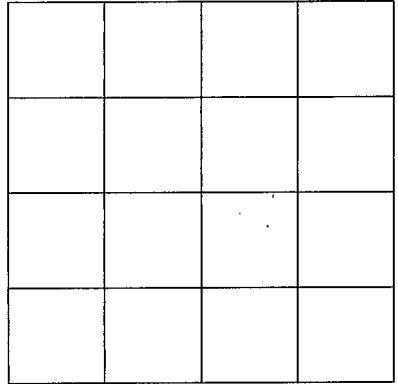

SECTION _____

Please indicate well location X.

ADDITIONAL INFORMATION

If more than one screen,
show location of each on sketch.