

PEARL RIVER
T 1
6-4-71

MISSISSIPPI
BOARD OF WATER COMMISSIONERS
416 North State Street
Jackson, Mississippi 39201

CODED

WATER WELL DRILLERS LOG

June 4 1971 NEIL LUMPKIN WELL DRILLING SERVICE Pearl River
date well completed P. O. BOX 117
CANTONMENT, MISS. county well located

LANDOWNER: Howard Tucker
Percayune, Miss.
Route
(mailing address)

description of formations encountered	from	to
Surface Clay	0	10
Sand & gravel	10	120
Blue Clay	120	350
Sand, good	350	550
Blue Clay	550	680
Good sand	680	766

WELL LOCATION:
sec 31 T 5 S R 18 W
8 miles W of Percayune
(distance) (direction) (nearest town)

WELL PURPOSE: home
(home, irrigation, municipal, industrial)

WELL COMPLETION DATA:

(1) diameter (inches) 2"
(2) total depth (feet) 766
(3) static water level (feet) 45 below above top of ground.
(4) casing 2" blk (material) (depth)
2" (size) if telescope see back.
(5) screen 20' (length) (depth to top)
2" (size) St. Steel (material)
(6) pump (HP) (yield gpm)
(type power)
(7) electric log no (yes or no)
(organization running log)

CODED

(8) how well bottom plugged Johnson
AP Valve


DRILLERS REMARKS:
19 lbs. pressure

JUN 8 1971

MISS. BD. OF
WATER COMM.

If well telescopes please sketch and show depths.

GROUND LEVEL

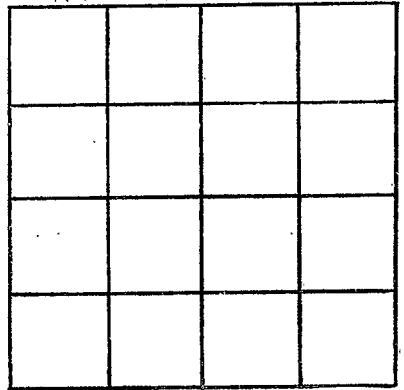

SECTION _____

Please indicate well location X.

ADDITIONAL INFORMATION

If more than one screen,
show locations of each on sketch.