

T-4

1-14-61

WATER WELL DRILLERS LOG

(P)

Date: 1-14, 1961, Driller: Jacky Born **CODED** County Pearl R.

8188 (Name)

8083

(1) Owner of Land: Robert Price
(Name)

Industrial Community
(Address)

(2) Location: 1/4, 1/4, Sec. 28 T5R18,
9 miles West, of Pearl
(distance) (direction) (Nearest Town)

(3) Topography: _____
(Hilly) (Flat) (Level)

(4) Purpose of Well: Domestic
(Domestic Irrigation
Municipal, Industrial, Other)

Description & Color of Materials Sand, Clay, Red Clay, Shell, etc.	Thick- ness Feet	Depth Feet
	0	15
	15	65
	105	315
	315	470
	470	720
	720	745
	745	790
	790	883

Information upon completion of well:

(1) Diameter 2 inches.

(2) Total Depth 883 feet.

(3) Water Level Flow feet below top of ground.

(4) Cased to _____, Size _____

(5) Screen: Size 2", Length 10"

(6) Were any formations sealed against pollution?
_____ yes, ✓ no.


If YES depth of formation _____

Why _____

Drillers Remarks: 15 lbs Pressure

45 gal Per minute

CODED

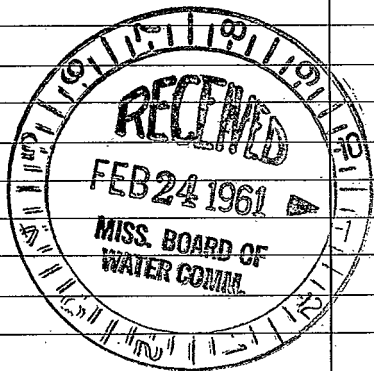

#43

(Use Back Side)

Well No.

