

WT-5  
6-13-64

WATER WELL DRILLERS LOG

Date: 6-13, 1964, Driller: Walter Perford **CODED** Pearl River  
(Name)

(1) Owner of Land: Arzo Snelgrove  
(Name)  
Picayune Miss  
(Address)

(2) Location: 1/4, 1/4, Sec. 35 T5 R8,  
5 miles West of Picayune  
(distance) (direction) (Nearest Town)

(3) Topography: Flat  
(Hilly) (Flat) (Level)

(4) Purpose of Well: Domestic  
(Domestic Irrigation  
Municipal, Industrial, Other)

Description & Color of Materials Sand, Clay, Red Clay, Shell, etc.	Thick- ness Feet	Depth Feet
<u>Yellow Clay</u>	<u>16</u>	<u>16</u>
<u>Sand + Gravel</u>	<u>59</u>	<u>75</u>
<u>Blue Clay</u>	<u>8</u>	<u>83</u>
<u>Grey sand</u>	<u>107</u>	<u>190</u>
<u>Blue clay</u>	<u>178</u>	<u>368</u>
<u>Grey sand</u>	<u>108</u>	<u>476</u>
<u>Hard Blue Clay</u>	<u>118</u>	<u>594</u>
<u>Sandy mud</u>	<u>22</u>	<u>616</u>
<u>Hard Blue clay</u>	<u>124</u>	<u>740</u>
<u>Grey sand + Gravel</u>		<u>786</u>

Information upon completion of well:

(1) Diameter 2 inches.

(2) Total Depth 786 feet.

(3) Water Level Flow feet below top of ground.

(4) Cased to \_\_\_\_\_, Size \_\_\_\_\_

(5) Screen: Size .010, Length 25


(6) Were any formations sealed against pollution?  
\_\_\_\_\_ yes, \_\_\_\_\_ no.

If YES depth of formation \_\_\_\_\_

Why \_\_\_\_\_

Drillers Remarks: 20 lbs. Pressure

**CODED**

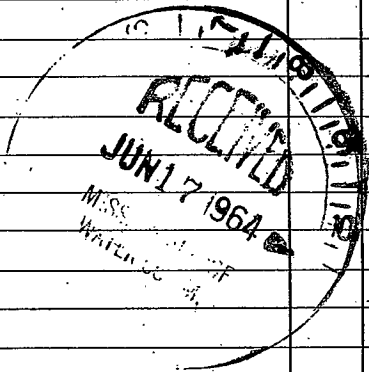

(Use Back Side)

Well No.

100