

Pearl River
T-6
9-4-71

MISSISSIPPI
 BOARD OF WATER COMMISSIONERS
 416 North State Street
 Jackson, Mississippi 39201

CODED

WATER WELL DRILLERS LOG

9-4 date well completed 71 Penton Well Serv firm name Pearl River county well located

LANDOWNER: J. W. Cothran
2808 Ventura Dr
Chalmette La.
 (mailing address)

description of formations encountered	from	to
Surface Clay	0	12
Sand & Gravel	12	41
Blue Clay	41	160
Sand	160	194

WELL LOCATION:
 sec. 29 T 5 S R 18 W
6 miles NW of Piceyune
 (distance) (direction) (nearest town)

WELL PURPOSE: Home
 (home, irrigation, municipal, industrial)

- WELL COMPLETION DATA:
- (1) diameter (inches) 2
 - (2) total depth (feet) 194
 - (3) static water level (feet) 3 below top of ground.
 - (4) casing Galv (material), 189 (depth)
2 (size) If telescope see back.
 - (5) screen 5' (length), 189 (depth to top)
2 (size), 5. Steel (material)
 - (6) pump - (HP), - (yield gpm)
- (type power)
 - (7) electric log NO (yes or no)
- (organization running log)
 - (8) how well bottom plugged B.W. Valve

CODED


SEP 25 1971

MISS. BD. OF
 WATER COMMISSIONERS

DRILLERS REMARKS:

If well telescopes please sketch and show depths.

GROUND LEVEL

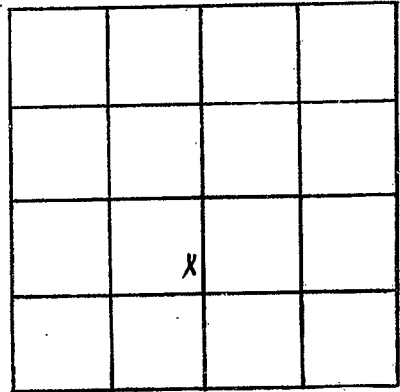

SECTION 29

Please indicate well location X.

ADDITIONAL INFORMATION

If more than one screen, show locations of each on sketch.