

PEARL RIVER
T 7
9-2-71

MISSISSIPPI
 BOARD OF WATER COMMISSIONERS
 416 North State Street
 Jackson, Mississippi 39201

WATER WELL DRILLERS LOG

9-2-71
 date well completed 19 71
 NEW LUMPKIN WELL DRILLING SERVICE Pearl River
 P. O. BOX 117
 firm name CARRIERE, MISS. county well located

CODED

LANDOWNER: Ernest Hall & Robert Hall
~~Highway~~ Route
 Picayune, Miss.
 (mailing address)

description of formations encountered	from to	
Surface clay	0	10
Sand & gravel	10	90

WELL LOCATION:
 sec. R 6 T 5 S R. 18 W
8 miles W of Picayune
 (distance) (direction) (nearest town)

Blue clay	90	150
Good sand	150	250

WELL PURPOSE: 2 homes
 (home, irrigation, municipal, industrial)

Blue clay	250	400
-----------	-----	-----

WELL COMPLETION DATA:

- (1) diameter (inches) 2"
- (2) total depth (feet) 861
- (3) static water level (feet) 40 ~~feet~~ above top of ground.
- (4) casing black (material), (depth)
2" if telescope see back.
 (size)
- (5) screen 20' (length), (depth to top)
2" ST. Screen (size), (material)
- (6) pump (HP) (yield gpm)
 (type power)
- (7) electric log no (yes or no)
 (organization running log)
- (8) how well bottom plugged

Good sand	400	550
Blue clay	550	700
Sand, no good	700	750
Blue clay	750	790
Good sand	790	861

CODED


OCT 11 1971

DRILLERS REMARKS:
18 lbs pressure

MISS. BO. OF
 WATER COMMISSIONERS

If well telescopes please sketch and show depths.

GROUND LEVEL

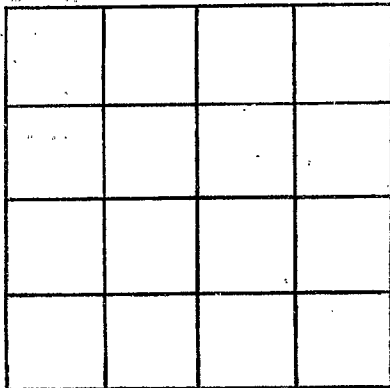

SECTION _____

Please indicate well location X.

ADDITIONAL INFORMATION

If more than one screen, show locations of each on sketch.