

PEARL RIVER
T 8
2-24-72

MISSISSIPPI BOARD OF WATER COMMISSIONERS **CODED** 1972
 416 North State Street
 Jackson, Mississippi 39201

WATER WELL DRILLERS LOG


2-24 1972 Bud Penton's Son Pearl River
 date well completed firm name county well located

LANDOWNER: <u>Olis Bentley</u> <u>St. Louis, Miss</u>	description of formations encountered	from	to
(mailing address)			
WELL LOCATION:			
sec. <u>19</u> T <u>S</u> N R <u>18</u> E <u>5</u> miles <u>E</u> of <u>Pearl River</u> (distance) (direction) (nearest town)			
WELL PURPOSE: <u>Home</u> (home, irrigation, municipal, industrial)			
WELL COMPLETION DATA:			
(1) diameter (inches) <u>4 in</u>			
(2) total depth (feet) <u>50</u>			
(3) static water level (feet) <u>6 ft</u> below top of ground.			
(4) casing <u>PVC</u> <u>40</u> (material) (depth)			
(size) if telescope see back.			
(5) screen <u>10</u> <u>40</u> (length) (depth to top)			
<u>4x10</u> <u>PVC</u> <u>no 12</u> (size) (material)			
(6) pump <u>1/2</u> <u>850</u> (HP) (yield gpm)			
<u>electric</u> (type power)			
(7) electric log <u>NO</u> (yes or no)			
(organization running log)			
(8) how well bottom plugged <u>and stuck</u>			
DRILLERS REMARKS:			

CODED

If well telescopes please sketch and show depths.

GROUND LEVEL

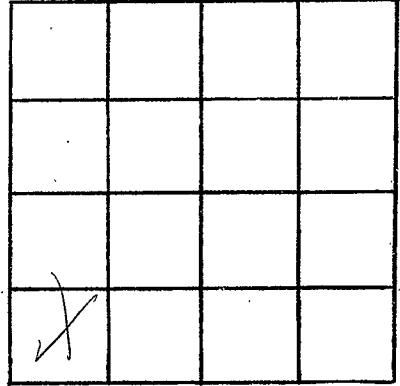

SECTION _____

Please indicate well location X.

ADDITIONAL INFORMATION

If more than one screen, show locations of each on sketch.