

PEARL RIVER
T 10
4-19-72

MISSISSIPPI
 BOARD OF WATER COMMISSIONERS
 416 North State Street
 Jackson, Mississippi 39201

CODED

WATER WELL DRILLERS LOG

4-19-72 **NEIL LUMPKIN WELL DRILLING SERVICE Pearl River**
 P. O. BOX 117
 date well completed 1972 **PEARL RIVER, MISS.** county well located

LANDOWNER: Charles S. Edgerton
 318 Sullivan Drive
 Bogalusa, La. 70427
 (mailing address)

description of formations encountered	from	to
Surface clay	0	20
Sand & gravel	20	60

WELL LOCATION:
 sec 29 T 5 S R 18 E
 8 1/2 miles SW of Picayune
 (distance) (direction) (nearest town)

Blue clay	60	140
Good sand	140	195

WELL PURPOSE: camp (trailer)
 (home, irrigation, municipal, industrial)

- WELL COMPLETION DATA:**
- (1) diameter (inches) 2"
 - (2) total depth (feet) 195
 - (3) static water level (feet) 7 below top of ground. above
 - (4) casing galv. (material), (depth)
2" (size) if telescope see back.
 - (5) screen 5' (length), (depth to top)
2" (size), Stainless Steel (material)
 - (6) pump 1/2 hp (HP) 600 gpm (yield gpm)
electric (type power)
 - (7) electric log no. (yes or no)

CODED

- (8) how well bottom plugged Sand-shale


DRILLERS REMARKS:

MAY 24 1972

PROD. DIV. OF
 MISSISSIPPI DEPARTMENT OF
 AGRICULTURE

If well telescopes please sketch and show depths.

GROUND LEVEL

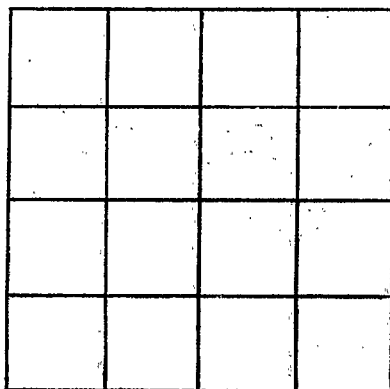

SECTION _____

Please indicate well location X.

ADDITIONAL INFORMATION

If more than one screen, show locations of each on sketch.