

PEARL RIVER
 T 13
 12-22-72

MISSISSIPPI
 BOARD OF WATER COMMISSIONERS
 416 North State Street
 Jackson, Mississippi 39201

CODED

WATER WELL DRILLERS LOG

NEIL LUMPKIN WELL DRILLING SERVICE *Pearl River*
 P. O. BOX 117
 CARROLL, MISS. county well located

12-22-1972
 date well completed

LANDOWNER: <i>Francis Sargent</i> <i>Picayune, Miss.</i> <i>Route 2</i> (mailing address)	description of formations encountered	from	to
		0	5

WELL LOCATION: sec. <u>35</u> T. <u>5</u> N. R. <u>18</u> E. <u>7</u> miles <u>W</u> of <u>Picayune</u> (distance) (direction) (nearest town)	5 <u>Blue Clay</u> <u>Grey artesian sand</u> <u>Blue Clay</u>	60	200
		200	316

WELL PURPOSE: <i>Home</i> (home, irrigation, municipal, industrial)	<u>Good sand</u> <u>Blue Clay</u> <u>Blue Clay</u> <u>Good sand</u>	550	650
--	--	-----	-----

WELL COMPLETION DATA: (1) diameter (inches) <u>2"</u> (2) total depth (feet) <u>798'</u> (3) static water level (feet) <u>40</u> below above top of ground.	<u>Blue Clay</u> <u>Good sand</u>	650	700
		700	798

(4) casing <u>galv.</u> (material) (depth) <u>2"</u> (size) if telescope see back.			
---	--	--	--

(5) screen <u>20'</u> (length) (depth to top) <u>2"</u> <u>S. Steel</u> (size) (material)			
--	--	--	--

(6) pump _____ (HP) (yield gpm) (type power) _____			
--	--	--	--

(7) electric log <u>No</u> (yes or no)			
---	--	--	--


(8) how well bottom plugged <i>Sand</i> <i>shark B.P.V.</i>			
--	--	--	--

DRILLERS REMARKS:			

JAN 11 1973

If well telescopes please sketch and show depths.

GROUND LEVEL

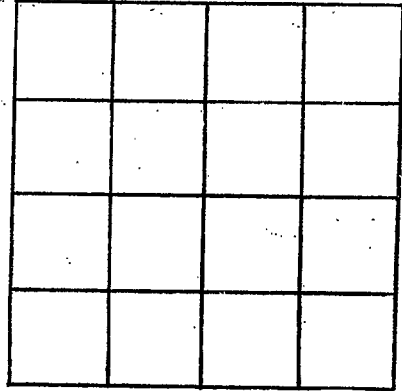

SECTION _____

Please indicate well location X.

ADDITIONAL INFORMATION

A series of horizontal lines providing space for additional information.

If more than one screen, show locations of each on sketch.