

PEARL RIVER  
T 15  
3-24-73

MISSISSIPPI  
BOARD OF WATER COMMISSIONERS  
416 North State Street  
Jackson, Mississippi 39201

**CODED**

WATER WELL DRILLERS LOG

March 24 19 73 Sumphin Well Sec Pearl River  
date well completed firm name county well located


LANDOWNER: <u>Kent Walter</u>	description of formations encountered	from	to
<u>Pearcyne, Miss</u>		<u>Surface Clay</u>	<u>0</u>
(mailing address)	<u>Surface Sandstone</u>	<u>15</u>	<u>200</u>
WELL LOCATION:	<u>Clay</u>	<u>200</u>	<u>260</u>
sec. <u>35</u> T <u>55</u> N R <u>18</u> E	<u>Sand</u>	<u>260</u>	<u>485</u>
S S W	<u>Clay</u>	<u>485</u>	<u>600</u>
<u>8</u> miles <u>West</u> of <u>Pearcyne</u>	<u>Sand</u>	<u>600</u>	<u>655</u>
(distance) (direction) (nearest town)	<u>Clay</u>	<u>655</u>	<u>745</u>
WELL PURPOSE: <u>Home</u>	<u>Brill. Sand</u>	<u>745</u>	<u>798</u>
(home, irrigation, municipal, industrial)			
WELL COMPLETION DATA:			
(1) diameter (inches) <u>2"</u>			
(2) total depth (feet) <u>798</u>			
(3) static water level (feet) <u>440</u> below above top of ground.			
(4) casing <u>Galv.</u> <u>798</u>			
(material) (depth)			
<u>2"</u>			
(size) If telescope see back.			
(5) screen <u>20'</u> <u>778</u>			
(length) (depth to top)			
<u>2</u> <u>Galv.</u>			
(size) (material)			
(6) pump <u>NONE</u>			
(HP) (yield gpm)			
(type power)			
(7) electric log <u>                    </u>			
(yes or no)			
(organization running log)			
(8) how well bottom plugged <u>BRP</u>			
DRILLERS REMARKS:			

**CODED**

APR 20 1973  
MISSISSIPPI  
WATER

If well telescopes please sketch and show depths.

GROUND LEVEL

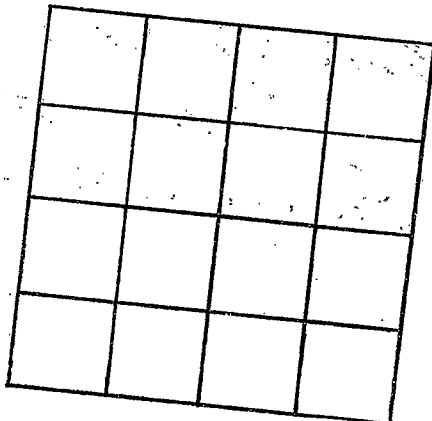

SECTION \_\_\_\_\_

Please indicate well location X.

ADDITIONAL INFORMATION

If more than one screen, show locations of each on sketch.