

Pearl R.

T 18

2-22-74

MISSISSIPPI

BOARD OF WATER COMMISSIONERS

416 North State Street

Jackson Mississippi 39201

CODED

WATER WELL DRILLERS LOG

2-22-1974 date well completed

Bud Penton & Son firm name

Pearl River county well located

LANDOWNER:

Otis Bentley  
McCaigney & Co  
(mailing address)

description of formations encountered

description of formations encountered	from	to
Red Shale	0	12
White Sand & Sack	12	50
Blue shale	50	510
Blue sand	510	628
Blue Shale	620	750
Gray Sand	750	798

WELL LOCATION:

sec. 19 T 5 R 18  
8 530 E  
(distance) (direction) (nearest town)

WELL PURPOSE: Home  
(home, irrigation, municipal, industrial)

WELL COMPLETION DATA:

(1) diameter (inches) 4 1/2

(2) total depth (feet) 798

(3) static water level (feet) 668 below top of ground

(4) casing Galv. 778 (material) (depth)

4 1/2 (size) if telescope see back.

(5) screen 2 x 20, 778 (length) (depth to top)

1/2 Stainless Steel (size) (material)

(6) pump (HP) (yield gpm)

(type power)

(7) electric log NO (yes or no)

(organization running log)

(8) how well bottom plugged Sand Shale

DRILLERS REMARKS:

NO pump furnished

CODED

RECEIVED  
MAY 21 1974


MISS. RD. OF WATER

If well telescopes please sketch and show depths.

GROUND LEVEL

63 ft. 4"

715 ft. 2"

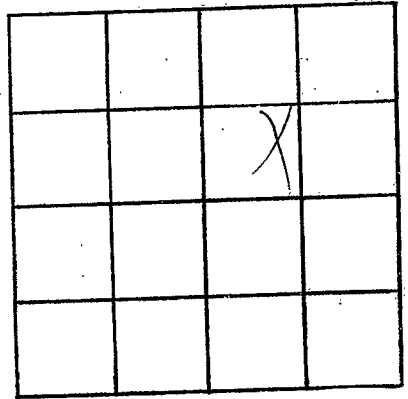

SECTION \_\_\_\_\_

Please indicate well location X.

ADDITIONAL INFORMATION

If more than one screen, show locations of each on sketch.