

P.R.
T 19
5-23-74

MISSISSIPPI
BOARD OF WATER COMMISSIONERS
416 North State Street
Jackson, Mississippi 39201

CODED

WATER WELL DRILLERS LOG

May 23 1974 Sumplin Well Ser. Paul Lewis
date well completed firm name county well located

LANDOWNER: W. C. Dixon
Picayune, Miss.
(mailing address)

WELL LOCATION:
sec. 14 T 5 N 3 R 18 E W
8 miles West of Picayune
(distance) (direction) (nearest town)

WELL PURPOSE: None
(home, irrigation, municipal, industrial)


- WELL COMPLETION DATA:
- (1) diameter (inches) 2"
 - (2) total depth (feet) 1134'
 - (3) static water level (feet) 3' below above top of ground.
 - (4) casing Galv. 1114'
(material) (depth)
2" if telescope see back.
(size)
 - (5) screen 20' 1114'
(length) (depth to top)
2" Stainless Steel
(size) (material)
 - (6) pump No 20# Pressure
(HP) (yield gpm)
No
(type power)
 - (7) electric log No
(yes or no)

(organization running log)
 - (8) how well bottom plugged Sand Shalt

description of formations encountered	from	to
Clay	0	10
Sand w/ shal	10	75
Clay	75	85
Sand	85	126
Clay	126	275
Sand	275	410
Clay	410	675
Sand	675	740
Clay	740	1080
Beal SD	1080	1134


CODED

DRILLERS REMARKS:

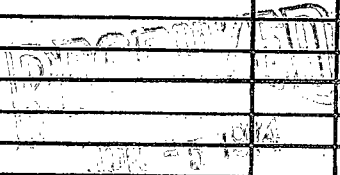

If well telescopes please sketch and show depths.

GROUND LEVEL

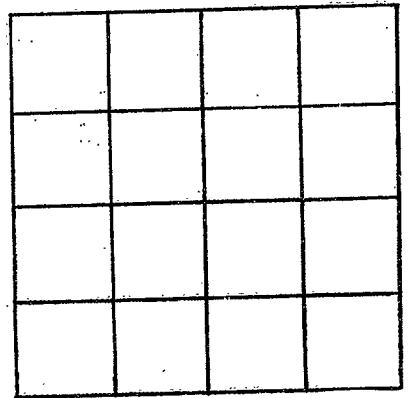

SECTION _____

Please indicate well location X.

ADDITIONAL INFORMATION

If more than one screen,
show locations of each on sketch.