

Pearl River  
T 20  
7-12-74

MISSISSIPPI  
BOARD OF WATER COMMISSIONERS  
416 North State Street  
Jackson, Mississippi 39201

CODED

WATER WELL DRILLERS LOG

July 12 1974 date well completed  
Lumpkin Well Ser. firm name  
Pearl River county well located

LANDOWNER: Wayle Costney  
New Orleans, La.  
(mailing address)  
WELL LOCATION:  
sec. 30 T 5 N R 18 E  
8 miles West of Pleasure  
(distance) (direction) (nearest town)

WELL PURPOSE: Home  
(home, irrigation, municipal, industrial)

- WELL COMPLETION DATA:
- (1) diameter (inches) 2"
  - (2) total depth (feet) 871'
  - (3) static water level (feet) 5" below above top of ground.
  - (4) casing Gal. 870'  
(material) (depth)  
2" if telescope see back.  
(size)
  - (5) screen 11 850'  
(length) (depth to top)  
2" Stainless Steel  
(size) (material)
  - (6) pump None 45  
(HP) (yield gpm)  
No  
(type power)
  - (7) electric log No  
(yes or no)  
No  
(organization running log)
  - (8) how well bottom plugged Sand & hard

description of formations encountered	from	to
Clay	0	10
Sand	10	70
Clay	70	120
Sand	120	230
Clay	230	275
Sand	275	450
Clay	450	575
Sand	575	690
Clay	690	710
Sand	710	755
Clay	755	805
Sand	805	871


CODED

RECEIVED  
AUG 8 1974

DRILLERS REMARKS:

If well telescopes please sketch and show depths.

GROUND LEVEL

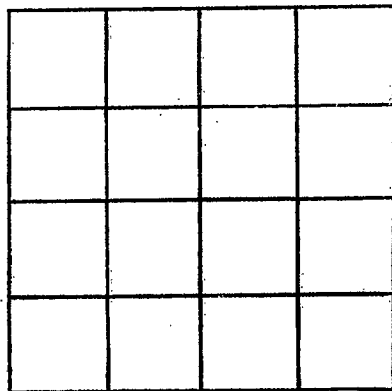

SECTION \_\_\_\_\_

Please indicate well location X.

ADDITIONAL INFORMATION

If more than one screen, show locations of each on sketch.