

Pearl River  
T24  
1-25-75

MISSISSIPPI  
BOARD OF WATER COMMISSIONERS  
416 North State Street  
Jackson, Mississippi 39201

CODE

WATER WELL DRILLERS LOG

1-25 1975 date well completed  
Pentax Well Serv firm name  
Pearl River county well located

LANDOWNER: H. E. Johnson  
Houston, Texas  
UNKNOWN  
(mailing address)

| description of formations encountered | from | to  |
|---------------------------------------|------|-----|
| Surface Clay                          | 0    | 32  |
| Sand & Gravel                         | 32   | 75  |
| Blue Clay                             | 75   | 145 |
| Sand                                  | 145  | 172 |

WELL LOCATION:  
sec. 19 T 5 N. R. 18 E  
S. W.  
7 miles NW of Picayune  
(distance) (direction) (nearest town)

WELL PURPOSE: Home  
(home, irrigation, municipal, industrial)

- WELL COMPLETION DATA:
- (1) diameter (inches) 2
  - (2) total depth (feet) 172
  - (3) static water level (feet) 8 below top of ground.
  - (4) casing Galv. 162  
(material) (depth)  
2 if telescope see back.  
(size)
  - (5) screen 18' 162  
(length) (depth to top)  
2 S. Steel  
(size) (material)
  - (6) pump 1/2 9  
(HP) (yield gpm)  
Elec  
(type power)
  - (7) electric log NO  
(yes or no)

(organization running log)  
(8) how well bottom plugged B.W. Valve

DRILLERS REMARKS:

CODED


RECEIVED

APR 10 1975

MISS. BD. OF WATER COMMISSIONERS

If well telescopes please sketch and show depths.

GROUND LEVEL

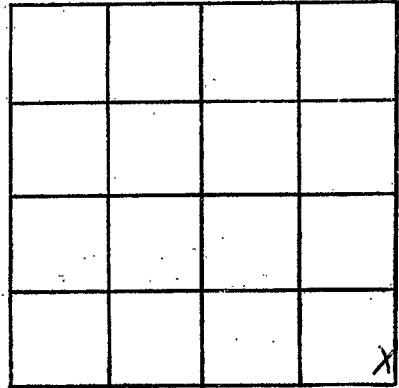

SECTION 19

Please indicate well location X.

ADDITIONAL INFORMATION

If more than one screen, show locations of each on sketch.