

Pearl River  
 T 25  
 1-67

MISSISSIPPI  
 BOARD OF WATER COMMISSIONERS  
 416 North State Street  
 Jackson, Mississippi 39201

WATER WELL DRILLERS LOG

CODED

1-27-1967 date well completed  
 67 Ponton Well Serv firm name  
 Pearl River county well located

LANDOWNER: Hulon Adcock

description of formations encountered	from	to
Red Clay	0	12
Sand	12	26
Sand + Gravel	26	72
Blue Clay	72	156
Grey Sand	156	174
Blue Clay	174	272
Grey Sand	272	294
Blue Clay	294	306
Grey Sand	306	412
Blue Clay	412	685
soft mud	685	756
Blue Clay	756	1090
Grey sand	1090	

(mailing address)

WELL LOCATION:  
 sec. 23 T. 5 S. R. 18 W.  
7 miles NW of Picayune  
 (distance) (direction) (nearest town)

WELL PURPOSE: Home  
 (home, irrigation, municipal, industrial)

WELL COMPLETION DATA:

- (1) diameter (inches) 5" Drilled
- (2) total depth (feet) 1155
- (3) static water level (feet) Flow <sup>+46</sup> below top of ground. <sub>above</sub>
- (4) casing Black steel, 1134,  
 (material) (depth)  
 (size) if telescope see back.
- (5) screen 20', 1134  
 (length) (depth to top)  
2", Stainless steel  
 (size) (material)
- (6) pump \_\_\_\_\_ (HP) \_\_\_\_\_ (yield gpm)  
 (type power)
- (7) electric log NO  
 (yes or no)  
 (organization running log)
- (8) how well bottom plugged BW Valve


CODED

NO lbs Pressure at Ground Level

DRILLERS REMARKS:  
Did Not Drill to Bottom of Sand

If well telescopes please sketch and show depths.

GROUND LEVEL

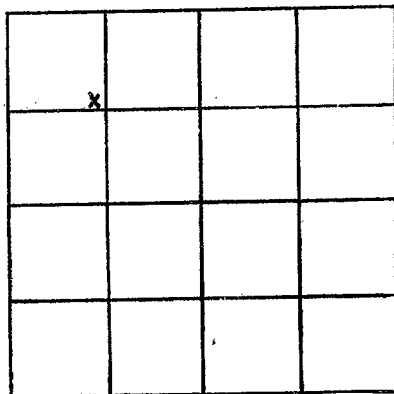

SECTION 23

Please indicate well location X.

ADDITIONAL INFORMATION

If more than one screen, show locations of each on sketch.